

Sec. 34 Twp. 16 R. 4E

Well No. #7 Martin "B" Farm

Youker et al Company

Lost Spring

990 Ft. from N. Line


990 Ft. from S. Line

_____ Ft. from E. Line

330 Ft. from W. Line

~~NW SW NW~~

SW NW NW

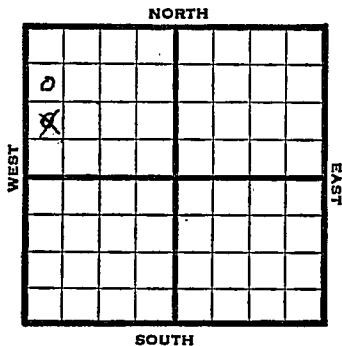

1947 Elev. 1373 REPORT

- 8/27 8" @ 120'
Drlg. 310'
- 9/3 Mississipi 2240
TD 5" @ 2240 Rust
- 9/10 Drlg. 2268'
1200' oil
- 9/17 Drlg. 2292'
1700' oil.
- 9/24 "
 - 10/1 Wiss 2240
 - 5" @ 2240
 - Pump 60 Pot
 - TD 2295
 - Gravity 36.2

COMPLETED

Map No. 26 Sec. 34 Twp. 16 R. 4E

Well No. 7 Martin "B"

Youker, et al.

Company

CORRECTION

Contractor

SW NW NW

SECTION PLAT

990 Ft. from N. Line

_____ Ft. from S. Line

_____ Ft. from E. Line

330 Ft. from W. Line

Dickinson County

Location _____

RECORD

Cased _____ in., _____ ft.

Rig up _____

Sand _____

Drilling and Remarks: _____

Gas _____

Oil _____

Total Depth _____

Reported

NW SW NW

PRODUCTION

1st 24 hrs. Nat. _____

1st 24 hrs. after shot _____

Gas _____ Cu. Ft.

Dry Hole _____

Abandoned _____

Date

SEP 3 1947 19

S. J. LEWIS

Scout

Map No. _____ Sec. 34 Twp. 16 R. 4E

Well No. 7 Martin "B"

Youker etal. Company

FIRST REPORT

Contractor

NW SW NW

SECTION PLAT

o			

_____ Ft. from N. Line

990 Ft. from S. Line

_____ Ft. from E. Line

330 Ft. from W. Line

Dickinson County

Location _____

Rig up _____

Drilling and Remarks:

8" @ 120

drlg. 310

RECORD

Cased _____ in., _____ ft.

Sand _____

Gas _____

Oil _____

Total Depth _____

PRODUCTION

1st 24 hrs. Nat. _____

1st 24 hrs. after shot _____

Gas _____ Cu. Ft.

Dry Hole _____

Abandoned _____

Date

AUG 27 1947

19

S. J. LEWIS

Scout

Map No. 26 Sec. 34 Twp. 16 R. 4E

Well No. 7 Martin "B"

Youker etal. Company

COMPLETE

Contractor

SW NW NW

E1, 1373
SECTION PLAT

990 Ft. from N. Line

_____ Ft. from S. Line

_____ Ft. from E. Line

330 Ft. from W. Line

Dickinson County

Location _____

Rig up _____

Drilling and Remarks:

Miss 2240

5' @ 2240

Pump 600 BT

86 2 24

RECORD

Cased _____ in., _____ ft.

Sand _____

Gas _____

Oil _____

Total Depth 2295

PRODUCTION

1st 24 hrs. Nat. _____

1st 24 hrs. after shot _____

Gas _____ Cu. Ft.

Dry Hole _____

Abandoned _____

Date

OCT 1 1947 19

S. J. LEWIS

Scout