

KANSAS

Dickinson

Sec. 34 Twp. 16 R. 4-E

Well No. 9. Martin "B" Farm

Youker etal Company

Lost Spring Pool


330 Ft. from N. Line

Ft. from S. Line

Ft. from E. Line

990 Ft. from W. Line

NE NW NW

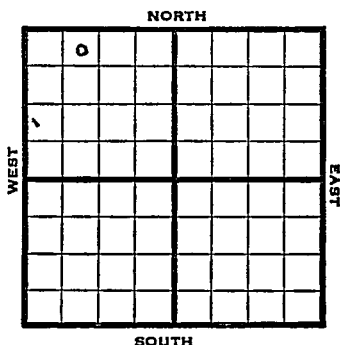

1947

R E P O R T

9/3	Loc.
9/10	"
9/17	"
9/24	"
10/1	"
10/8	"
10/15	"
10/22	"
10/29	"
11/5	"
11/12	Spud
11/19	8" @ 160' Mississippi 2275' TD 2275' 5" @ 2275' WOC
11/25	"
12/3	TD 2324' 1300' oil
12/10	"

.1947

12/17 Mississippi 2275'
 5" @ 2275'
 Pump 45 Pot
 TD 2324
 Gravity 37

COMPLETED

Map No. _____ Sec. 34 Twp. 16 R. 4E

Well No. 9 Martin "B"


Youker etal. Company

FIRST REPORT

Contractor

NE NW NW

SECTION PLAT

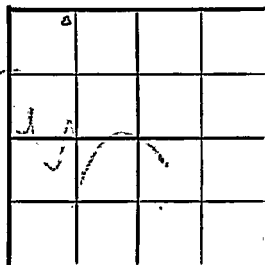

330 Ft. from N. Line

_____ Ft. from S. Line

_____ Ft. from E. Line

990 Ft. from W. Line

Dickinson County

Location X

Rig up _____

Drilling and Remarks: _____

RECORD

Cased _____ in., _____ ft.

Sand _____

Gas _____

Oil _____

Total Depth _____

PRODUCTION

1st 24 hrs. Nat. _____

1st 24 hrs. after shot _____

Gas _____ Cu. Ft.

Dry Hole _____

Abandoned _____

Date

SEP 3 1947 19

S. J. LEWIS Scout

Wm. H. H. H.

Wm. H. H. H.

Misc. Small Maps	<i>Wm. H. H. H.</i>
Cards	<i>Wm. H. H. H.</i>
Tracing	<i>Wm. H. H. H.</i>
France Map	<i>Wm. H. H. H.</i>
Scarborough Map	<i>Wm. H. H. H.</i>
Pierce Map	<i>Wm. H. H. H.</i>
Geological Dept.	<i>Wm. H. H. H.</i>
Pierce Plat Book	<i>Wm. H. H. H.</i>

Map No. 26 Sec. 34 Twp. 16 R. 4E

Well No. 9 Martin "B"

Youker etal. Company

COMPLETE Contractor

NE NW NW


E11408
SECTION PLAT

330 Ft. from N. Line

 Ft. from S. Line

 Ft. from E. Line

990 Ft. from W. Line

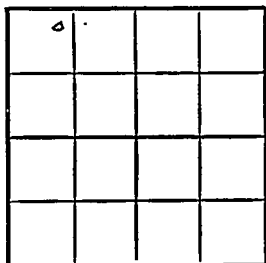

Dickinson County

Location

Rig up

Drilling and Remarks:

Miss 2275-

5" @ 2275

Pump 45 P.S.

87 2/3

RECORD

Cased in., ft.

Sand

Gas

Oil

Total Depth 2224

PRODUCTION

1st 24 hrs. Nat.

1st 24 hrs. after shot

Gas Cu. Ft.

Dry Hole

Abandoned

Date

DEC 17 1947 19

S. J. LEWIS Scout

Wm H

Misc. Small Maps	<i>2</i>
Cards	<i>Claine</i>
Tracing	<i>J</i>
France	<i>1</i>
Geo	<i>1</i>
Fl	<i>1</i>
Cc	<i>1</i>
Pic	<i>1</i>