

Section 34 Township 16 Range 4E


Well No. #3 Biechler (Biehler)

Company Hutchinson Oil & Gas

NORTH

WEST

EAST

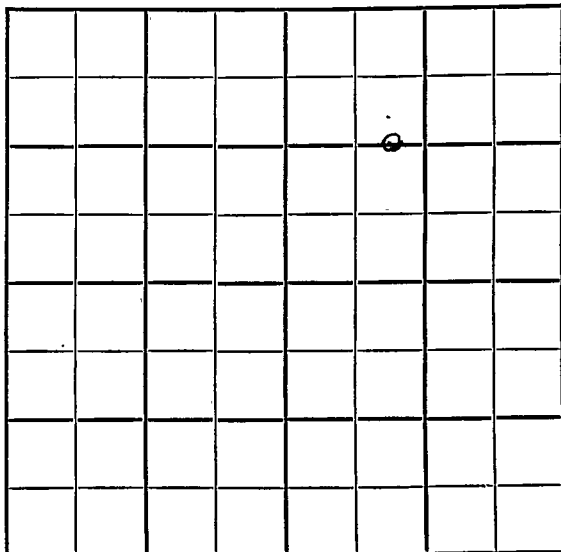

SOUTH

KANSAS

Dickinson

Sec. 34 Twp. 16 R. 4E

Well No. #3 Biechler Farm

Hutchinson Oil & Gas Company

Lost Spring


1320 Ft. from N. Line

 Ft. from S. Line

 Ft. from E. Line

990 Ft. from W. Line

C E L $W\frac{1}{2}$ NE

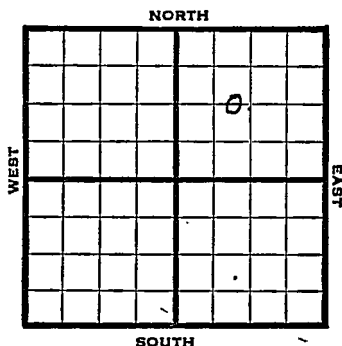

1948

REPORT

1/21 Location
1/26 8" @ 105'
Drlg 1800'
2/4 Drlg. 2100'
2/11 "
2/18 Miss. 2274'
5" @ 2276'
Pump 55 Pot
36.0 Gr.
TD 2314'
Comp

COMPLETED

Kansas

Map No. _____ Sec. 34 Twp. 16 R. 4EWell No. 3 BiechlerHutchinson Oil & Gas CompanyFIRST REPORT ContractorC E L W $\frac{1}{2}$ NE

SECTION PLAT

1320 Ft. from N. Line

_____ Ft. from S. Line

_____ Ft. from E. Line

990 Ft. from W. LineDickinson CountyLocation X

Rig up _____

Drilling and Remarks:

RECORD

Cased _____ in., _____ ft.

Sand _____

Gas _____

Oil _____

Total Depth _____

PRODUCTION

1st 24 hrs. Nat. _____

1st 24 hrs. after shot _____

Gas _____ Cu. Ft.

Dry Hole _____

Abandoned _____

Date

JAN 21 194819S. J. LEWIS Scout

Map No. 26 ^{Kansas} Sec. 34 Twp. 16 R. 4E

Well No. 3 Biehler

Hutchinson Oil & Gas Company

COMPLETE

Contractor

C E L W $\frac{1}{2}$ NE


SECTION PLAT

1320 Ft. from N. Line

 Ft. from S. Line

 Ft. from E. Line

990 Ft. from W. Line

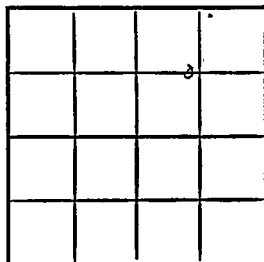

Dickinson County

Location

Rig up

Drilling and Remarks:

Miss 2277

5" C 2276

Pump 5500

26-2-4

RECORD

Cased in., ft.

Sand

Gas

Oil

Total Depth 2814

PRODUCTION

1st 24 hrs. Nat.

1st 24 hrs. after shot

Gas Cu. Ft.

Dry Hole

Abandoned

Date

FEB 18 1946

19

S. J. LEWIS

Scout