


Section 34 Township 16 Range 4E

Well No. #4 Biehler

Company Hutchinson Oil & Gas  
Lost Spring Pool  
NORTH

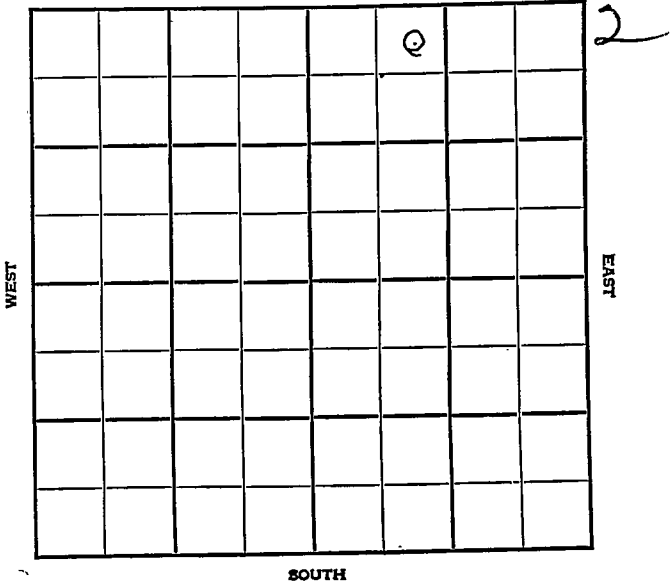

KANSAS  
16

Sec. 34 Twp. 7 R. 4E

Well No. #4 Biehler Farm

Hutchinson Oil & Gas Company


Lost Spring

330 Ft. from N. Line

\_\_\_\_\_ Ft. from S. Line

\_\_\_\_\_ Ft. from E. Line

990 Ft. from W. Line

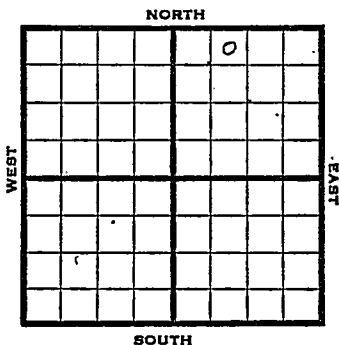

NE NW NE

1948

Elev. - REPORT

4/14

8" @ 106'  
Drlg. 550'

4/21

Mississippi 2287'  
TD 2287 $\frac{1}{2}$ '  
5" @ 2287'  
RUST

4/28

TD 2298'  
1200' oil

5/5

Miss 2287'  
5" @ 2287'  
Pump 50 oil Pot.  
Gr. 37°  
TD 2298'

**COMPLETED**

Map No. \_\_\_\_\_ Sec. 34 Twp. 16 R. 4E

Well No. 4 Biehler

Hutchinson Oil & Gas Company

**FIRST REPORT**

Contractor

NE NW NE

SECTION PLAT

330 Ft. from N. Line

\_\_\_\_\_ Ft. from S. Line

\_\_\_\_\_ Ft. from E. Line

990 Ft. from W. Line

			o

Dickinson County

Location \_\_\_\_\_

Rig up \_\_\_\_\_

Drilling and Remarks:

8" @ 106  
drlg. 550

RECORD

Cased \_\_\_\_\_ in., \_\_\_\_\_ ft.

Sand \_\_\_\_\_

Gas \_\_\_\_\_

Oil \_\_\_\_\_

Total Depth \_\_\_\_\_

PRODUCTION

1st 24 hrs. Nat. \_\_\_\_\_

1st 24 hrs. after shot \_\_\_\_\_

Gas \_\_\_\_\_ Cu. Ft.

Dry Hole \_\_\_\_\_

Abandoned \_\_\_\_\_

Date

APR 14 1948 19

S. J. LEWIS Scout

Map No. 26 Sec. 34 Twp. 16 R. 4E

Well No. 4 Biehler

Hutchinson Oil & Gas Company

COMPLETE Contractor

NE NW NE

SECTION PLAT

330 Ft. from N. Line

\_\_\_\_\_ Ft. from S. Line

\_\_\_\_\_ Ft. from E. Line

990 Ft. from W. Line

		0	

Dickinson County

Location \_\_\_\_\_

Rig up \_\_\_\_\_

Drilling and Remarks:

*Miss 2287*

*5' @ 2287*

*Pump 50 oil*

*87 1/2*

RECORD

Cased \_\_\_\_\_ in., \_\_\_\_\_ ft.

Sand \_\_\_\_\_

Gas \_\_\_\_\_

Oil

Total Depth 9295

PRODUCTION

1st 24 hrs. Nat. \_\_\_\_\_

1st 24 hrs. after shot \_\_\_\_\_

Gas \_\_\_\_\_ Cu. Ft.

Dry Hole \_\_\_\_\_

Abandoned \_\_\_\_\_

Date

MAY 5 1948

S. J. LEWIS Scout