


Section 34 Township 16 Range 4EWell No. #5 BiehlerCompany Hutchinson Oil & Gas  
Lost Spring Pool

NORTH

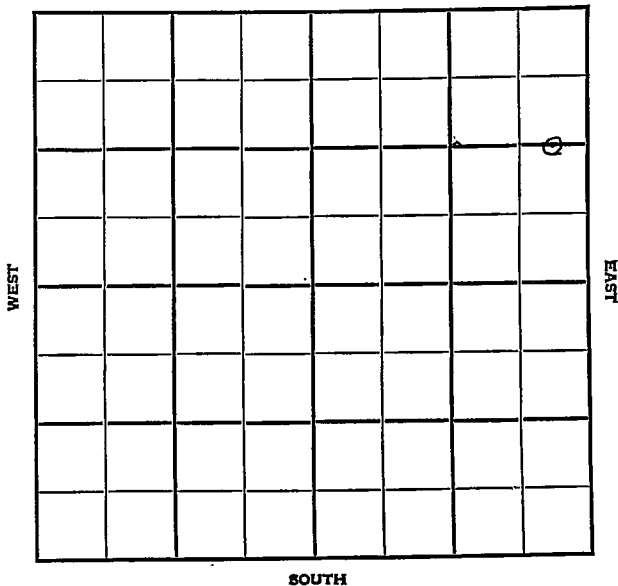

Sec. 34 Twp. 16 R. 4E

Well No. #5 Biehler Farm

Hutchinson Oil & Gas Company

Lost Spring


1320 Ft. from N. Line

\_\_\_\_\_ Ft. from S. Line

330 Ft. from E. Line

\_\_\_\_\_ Ft. from W. Line

C E L NE

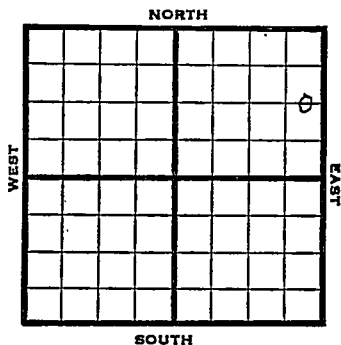

1948

Elev. 1418' REPORT

4/14

Location

4/21

8" @ 94'

WOC

4/28

Dr1g. 2205'

5/5

Miss. 2269'

5" @ 2269'

Pump 50 oil Pot.

Gr. 37°

TD 2319'

**COMPLETED**

Map No. \_\_\_\_\_ Sec. 34 Twp. 16 R. 4EWell No. 5 BiehlerHutchinson Oil & Gas Company

## FIRST REPORT

\_\_\_\_\_  
Contractor

C E L NE


## SECTION PLAT

1320 Ft. from N. Line

\_\_\_\_\_ Ft. from S. Line

330 Ft. from E. Line

\_\_\_\_\_ Ft. from W. Line

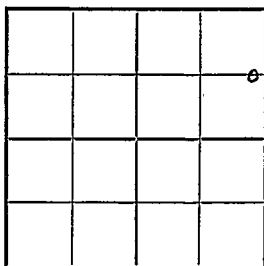Dickinson CountyLocation X

Rig up \_\_\_\_\_

Drilling and Remarks:

## RECORD

Cased \_\_\_\_\_ in., \_\_\_\_\_ ft.

Sand \_\_\_\_\_

Gas \_\_\_\_\_

Oil \_\_\_\_\_

Total Depth \_\_\_\_\_

## PRODUCTION

1st 24 hrs. Nat. \_\_\_\_\_

1st 24 hrs. after shot \_\_\_\_\_

Gas \_\_\_\_\_ Cu. Ft.

Dry Hole \_\_\_\_\_

Abandoned \_\_\_\_\_

Date

APR 14 1948

19

S. J. LEWIS Scout

Form 26—200 Bks.—1-48—Palace  
Kansas

Map No. 26 Sec. 34 Twp. 16 R. 4E

Well No. 5 Biehler

Hutchinson Oil & Gas Company  
**COMPLETE**

C E L NE

Contractor

*E. 11418*


SECTION PLAT

1320 Ft. from N. Line

         Ft. from S. Line

330 Ft. from E. Line

         Ft. from W. Line

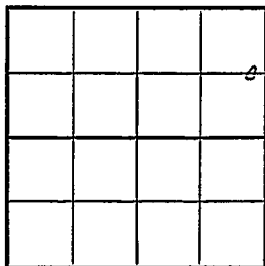

Dickinson County

Location                         

Rig up                         

Drilling and Remarks:

*Miss 2269*

*5" C 2269*

*Pump 50 oil Bx*

*37° E*

RECORD

Cased          in.,          ft.

Sand                         

Gas                         

Oil                         

Total Depth 2819

PRODUCTION

1st 24 hrs. Nat.                         

1st 24 hrs. after shot                         

Gas                          Cu. Ft.

Dry Hole                         

Abandoned                         

Date

MAY 5 1948 19

S. J. LEWIS Scout