

**KANSAS**


Dickinson County

FORM 51 5M BR1X

Section 34 Township 16 Range 4E

Well No. 2 Daetwiller (Daetweiler)

Company R. E. Youker

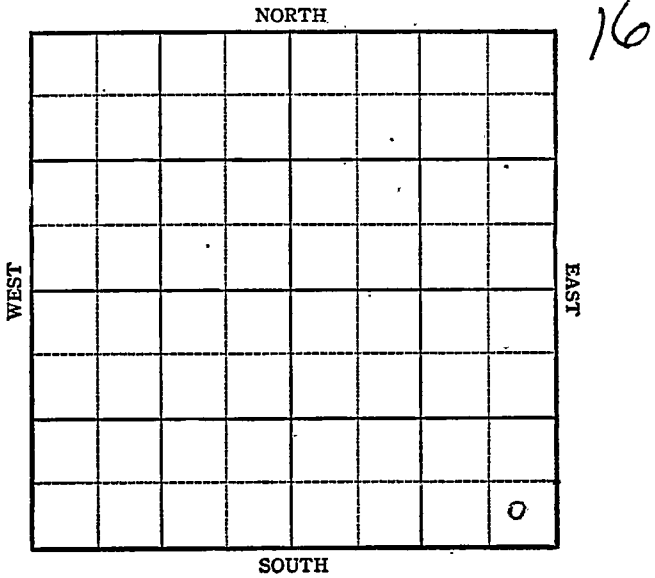

34 **KANSAS**

Dickinson

16

4E

Sec. \_\_\_\_\_ Twp. \_\_\_\_\_ R. \_\_\_\_\_

Well No. #2 Daetwiler Farm

R E Youker Company

Lost Spring

\_\_\_\_\_ Ft. from N. Line


400'

\_\_\_\_\_ Ft. from S. Line

400'

\_\_\_\_\_ Ft. from E. Line

\_\_\_\_\_ Ft. from W. Line

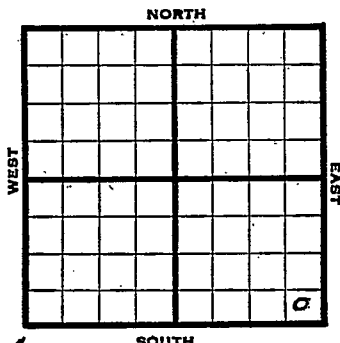

*Elev. 1434*

1944

REPORT

6/28 Cellar  
 7/12 10" @ 120 Drlg 650  
 7/19 Drilling 950  
 7/26 8" @ 1535 7" @ 1700 Drlg. 1905  
 8/9 Miss. 2295  
 5" @ 2321  
 Pump 15 Pot.  
 Grav. 36.0  
 TD 2382

COMPLETED



