


Section 35 Township 16 Range 4 E

Well No. #1 Utech "A"

Company Slusser Drlg.

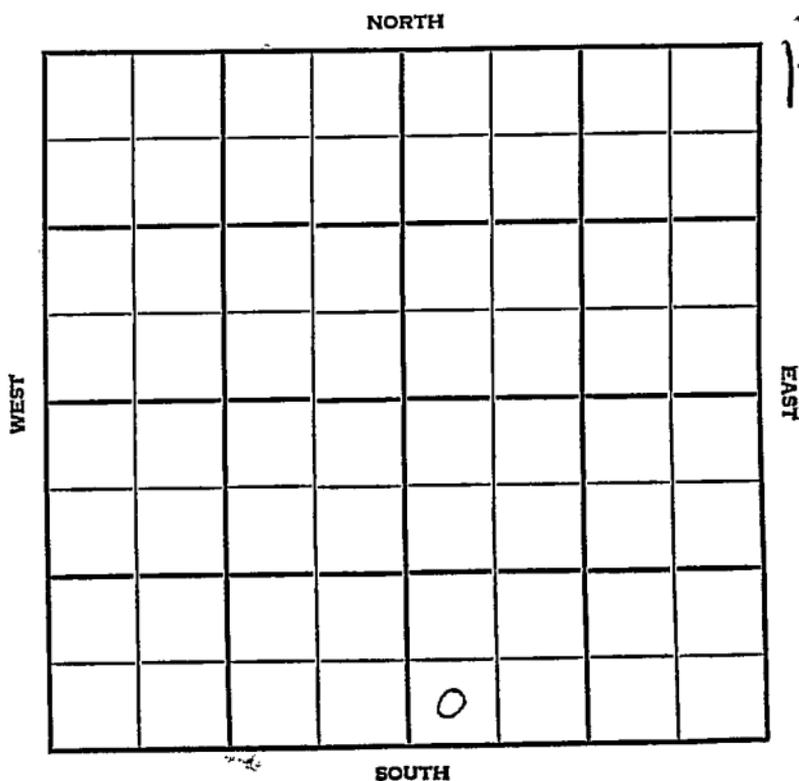

Dickinson

KANSAS


SEC.	TWP.	R.
35	16	4E

WELL NO. #1 Utech "A" FARM

COMPANY Slusser Drlg.

CONTRACTOR Co. Tools
Lost Springs

_____ Ft. from N. Line
 _____ Ft. from S. Line
 _____ Ft. from E. Line
 _____ Ft. from W. Line

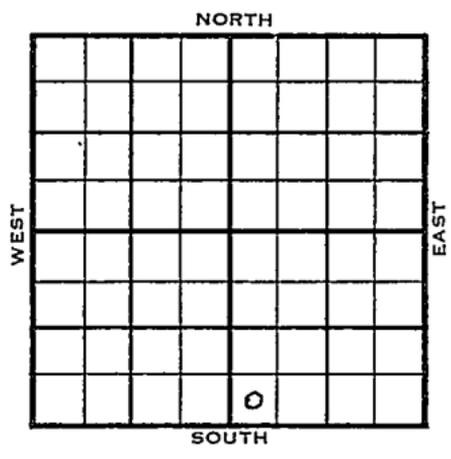

SW SW SE

1955	ELEVATION	REPORT
	1499'	

8/17 R U R

9-21 Comm. 8-16-55
 8 5/8" @ 104 2/90
 5 1/2" @ 2315 w/75 no tst
 Frac POP P ld P 5 bo plus 5 bwpd
 Tops: M. 2305'
 T.D. 2315'

COMPLETED
 COMPLETED

County **Dickinson** Elev. _____
 Sec. **35** Twp. **16** Rgs. **4E**
 Company **Slusser Drlg.**
 Farm Name **Utech "A"** No. **1**

Co.

TOPS	DEPTH	LOG	DATUM
Anh.			
Tp.			
H.			
Tr.			
Dg.			
Bl.			
L.			
K.C.			
B.K.C.			
Ce.			
C.			
M.			
M.			
K.			
Mz.			
Mo.			
V.			
S.			
S.			
A.			
R.			
PE.			
G.			
TD.			

Loc. in Sec. **SW SW SE**

Geol. _____

Contr. _____

Co. tools

Pool _____

Lost Springs

AUG 17 '55
FIRST REPORT

Use.

No.

Sec.

T.

R.

Date Comm. **RUR**

No County

County Dickinson Elev. 7199


Sec. 35 Twp. 16 Rge. 4E

Company Slusser Drlg.

FarmName Utech "A" No. 1

TOPS	DEPTH	LOG	DATUM
Anh.			
Tp.			
H.			
Tr.			
Dg.			
Bl.			
L.			
K.C.			
B.K.C.			
Ce.			
C.			
M.	<u>2305</u>		<u>956</u>
M.			
K.			
Mz.			
Ma.			
V.			
S.			
S.			
A.			
R.			
PE.			
G.			
T.D.	<u>2315</u>		

Loc. in Sec. SW SW SE
 Geol. _____
 Contr. _____
 Pool _____
 Lost Springs _____

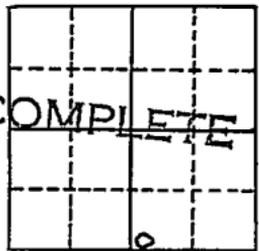

Date Comm. 8/16/55 SEP 21 1955

8 5/8" 10 1/4 2/90 5 1/2" 2315 w/75 no tst

Frac POP P 1d P 5 bo plus 5 bwpd

Co.
Lse.
No.
Sec.
T.
R.