

Section 35 Township 16 Range 5E

Well No. #3 Grass

Company ~~Ray Loriaux et al~~ Grassland Oil Co.

NORTH

WEST								EAST

SOUTH

16

0

Morris

O.W.W.O. KANSAS

Sec. 35 Twp. 16 R. 5 E

Well No. # 3 Grass Farm

~~Ray Loriaux et al~~ Grassland Oil Co Company

Slusser Drlg. Contractor

3 Mile Creek


 Ft. from N. Line

990 Ft. from S. Line

330 Ft. from E. Line

 Ft. from W. Line

NE SE SE

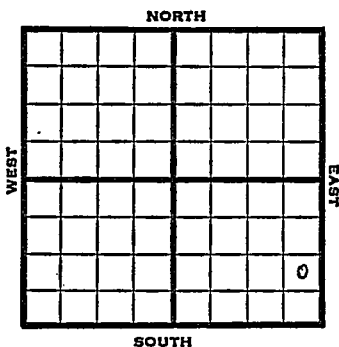

1951

Elev. -

REPORT

10/10

RUR

11/7

Spud 10-11-51
Oil Well TD 2230
8" @ 148
Miss 2188-90
5" @ 2189
TD 2230 FU 1200' fluid
30% oil S/ 6 BOPH 7 BW
Comp. 35 BOPD 40 BW

COMPLETED

1955

O.W.W.O.

9-21

Old Info- 5 $\frac{1}{2}$ " @ 2189; OTD 2230
was Miss. well
NEW INFO: RUCT;
CO DD 2543 TD;
370' of 4" liner @ 2463;
CO 2543; 300 A; input 4 bwpm
Comp. SWDW
Miss Ls. 2188
K. 2264

FIRST REPORT

[Handwritten signature]

ABANDONED

County **Morris** State **Kansas**

Sec. **35** (Blk. **16** (Sur. **5E** Map No.

Operator **Ray Loriaux et al.**

Well No. 3 Farm Grass

Elev.	Location	NE	SE	SE
-------	----------	----	----	----

FIRST REPORT

990 Ft. From S Line SE

330 Ft. From E Line Quarter

Ist. Report OCT 10 1951

Completion

Remarks


Slusser Drlg.-Contr.

Spudding Date _____

Drlg. Data **3 Mile Creek**

FOR

County Morris State Kansas
 Sec. 35 (Blk.) 16 (Sur. Rge.) 5E Map No. _____
 Operator Ray Lariaux et al.
 Well No. 3 Farm Grass
 Elev. _____ Location NE SE SE

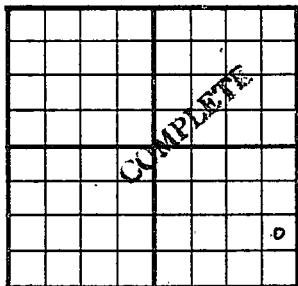

990 Ft. From S Line SE

330 Ft. From E Line Quarter

Ist. Report _____

Completion NOV 7 1951

Remarks 3 Mile creek Pool

Slusser Drlg. - Contr.

Spudding Date 10-11-51

Drlg. Data Oil well TD 2230

8" @ 148 Miss. 2188-90 5" @ 2189

TD 2230 FU 1200' fluid 30% oil

S/ 6 boph 7 bw Comp. 35 bopd 40 bw

J. E. TYRA

Mc County
O.W.W.O.

FORM 513 REV. SUNRAY



County Marion Elev. 1439 DF
 Sec. 35 Twp. 16S Rge. 5E
 Company Graseland Oil Co.
 Farm Name Grase No. 3

TOPS	DEPTH	LOG	DATUM
Anh.			
Tr.			
H.			
Tr.			
Dg.			
Bl.			
L.			
K.C.			
B.K.C.			
Ce.			
C.			
Miss Is.	2188		
M.			
K.	2264		
Mz.			
Me.			
V.			
S.			
S.			
A.			
R.			
Pe.			
G.			
TD.			

Loc. in Sec. NE SE SE
 Geol.
 Contr.
 Pool 3 mi. Creek

FIRST REPORT
 7
 ABANDONED

Date Comm. Old info - 5 1/2" 2189; OTD 2230;
was Miss. well

New info - RUCT; CO DD 2543TD; 370' of 4"
liner at 2463; CO 2543; 300 A; input
4 bpm

Comp. SWDW

Co.
Lse.
No.
Sec.
T.
R.