


Section 35 Township 16 Range 5EWell No. #4 Gross (Grass)Company Grassland O. I.
A. Loriaux Oil Co.

NORTH

WEST

EAST

SOUTH

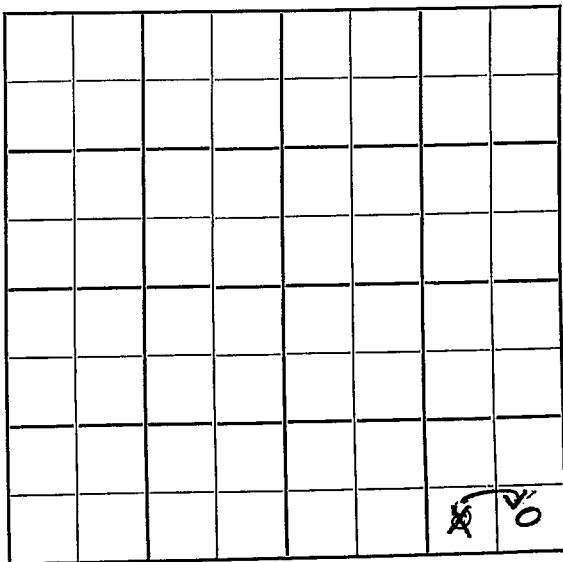

Morris

KANSAS ✓

Sec. **35** Twp. **16** R. **5E**

Well No. **#4 Gross** Farm

Grossland Oil
A. Loriaux Oil Co. Company


Slusher Contractor

Ft. from N. Line

330 Ft. from S. Line

330
990 Ft. from E. Line

Ft. from W. Line

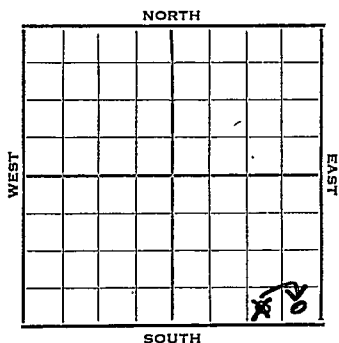

~~SW SE SE~~
SE SE SE

1952

Elev. - **REPORT**

5/7 Location

6/11 Spud 5-15-52
Oil well TD 2241' 8" @ 145
Miss 2194-96 5" @ 2196 TD 2241'
FU 300' oil 1200' water 10 hr.
S/3 BOPH Est 50% water
Comp. 30 BOPD 30 BW

COMPLETED



J. G. McGEHEE

Map No. _____ Sec. 35 Twp. 16 R. 5EWell No. 4 GrossGrossland Oil CompanyCORRECTION Contractor

SE SE SE

SECTION PLAT

_____ Ft. from N. Line

330 Ft. from S. Line330 Ft. from E. Line

_____ Ft. from W. Line

			a

Morris County

Location _____

Rig up _____

Drilling and Remarks:

Reported.

A. Loriaux

#4 Gross

SW SE SE

RECORD

Cased _____ in., _____ ft.

Sand _____

Gas _____

Oil _____

Total Depth _____

PRODUCTION

1st 24 hrs. Nat. _____

1st 24 hrs. after shot _____

Gas _____ Cu. Ft.

Dry Hole _____

Abandoned _____


Date

MAY 14 1952

19

J. G. McGEHEE

Scout

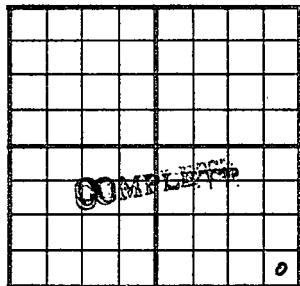County Morris State KansasSec. 35 (Blk.
Twp.) 16 (Sur.
Rge.) 5E Map No.Operator Grassland OilWell No. 4 Farm GrossElev. Location SE SE SE

330 Ft. From S Line SE

330 Ft. From E Line Quarter

1st. Report

Completion JUN 11 1952

Remarks

Slusser Drlg. & Contr.Spudding Date 5-15-52Drlg. Data Oil well TD 22418" @ 145 Miss. 2194-96 5" @ 2196TD 2241 FU 300' oil 1200' water10 hr. S/ 3 boph est. 50% waterComp. 30 bopd 30 bw

J. G. McGEHEE