

Mirris

KANSAS

SECTION 35 TOWNSHIP 16 RANGE 5 E

WELL NO. #1 Jacobson

COMPANY Bert Young et al

NORTH

						0	

WEST

EAST

SOUTH

8

Morris

KANSAS

SEC. 35	TWP. 16	R. 5E
------------	------------	----------

WELL NO.

#1 Jacobson

FARM

COMPANY

Bert Young etal


CONTRACTOR

_____ Ft. from N. Line

_____ Ft. from S. Line

_____ Ft. from E. Line

_____ Ft. from W. Line

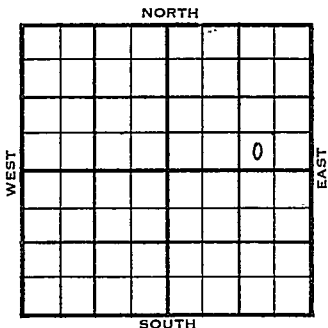

SW SE NE

1956	ELEVATION 1452'	REPORT
------	--------------------	--------

2-1

~~#1#1#1#~~
 4 1/2" @ 2209
 WOC
 M. 2192
 TD 2247

No *County Map*
 Morris Elev. 1452

County 35 Twp. 16 Rge. 5E
 Company Bert Young et al.
 Farm Name Jacobson No. I

TOPS	DEPTH	LOG	DATUM
Anh.			
Tp.			
H.			
Tr.			
Dg.			
Bl.			
L.			
K.C.			
B.K.C.			
Ce.			
C.			
M.	2192		
M.			
K.			
Mz.			
Mq.			
V.			
S.			
S.			
A.			
R.			
PE.			
G.			
T.D.	2247		

Loc. in Sec. SWSENE

Geol. _____
 Contr. _____

Pool _____

FIRST REPORT
 FEB 7 '56

Date Comm. 1 1/2 @ 2209 WOC

Co.
 Lse.
 No.
 Sec.
 T.
 R.

No County Map

County Morris Elev. 1152
 Sec. 35 Twp. 16 Rge. SE
 Company Bert Young et al.
 Farm Name Jacobson No. 1

TOPS	DEPTH	LOG	DATUM	Loc. in Sec.
Anh				SW SE NE
Tr.				
H.				
Tr.				
Dg.				
Bl.				
L.				Geol.
K.C.				Contr.
B.K.C.				
Ce.				
C.				
M.	2192		740	Pool
M.				
K.				
Mz.				
Me.				
V.				
S.				
S.				
A.				
R.				
PE.				
G.				COMPLE
ED.	2247			

Date Comm. FEB 1 5 1956
1 1/2 @ 2209 WOC FEB 8 '56 CU 2247

FU 850' Fluid 8 hrs (10% oil)
\$ 150' Fluid (10% oil) FEB 1
Pop P 10 Bopd + 75%

55