


Dickinson **KANSAS**

SECTION 35 TOWNSHIP 16 RANGE 4 E

WELL NO. #3 Utech

COMPANY Slusser Drlg.

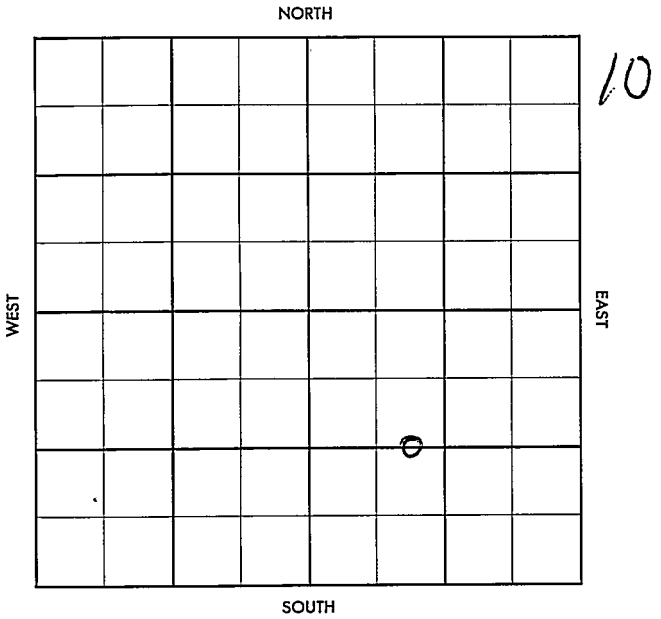

Dickinson

KANSAS

SEC.	TWP.	R.
35 - -	16	4E

WELL NO.

#3 Utech

FARM

COMPANY

Slusser Drlg.

CONTRACTOR

Co. tools

Lost Springs

NORTH

Ft. from N. Line

Ft. from S. Line

Ft. from E. Line

Ft. from W. Line

WEST

EAST

C $E\frac{1}{2}$ $W\frac{1}{2}$ SE

SOUTH

	ELEVATION	REPORT
1956	1425'	

1-5 Cellar & pits

4-25 Comm. 1-5-56

8 $5/8$ " @ 101 w/5005 $1/2$ " @ 2287 w/25

CO DD 2325

Comp. 10 bopd, 10 bw

MChat 2276

TD2325'

COMPLETED

Elev.

Reg. 4E

Company Slusser Drlg.

No. 3

TOPS	DEPTH	LOG	DATUM
Anh.			
TP.			
H.			
Tr.			
Dg.			
BL.			
L.			
K.C.			
B.K.C.			
Ce.			
C.			
M.			
M.			
K.			
Mz.			
Mq.			
V.			
S.			
S.			
A			
R.			
PE.			
G.			
FD.			

Loc. in Sec.

C E¹ W¹ SE

Geol.

Contr

Co. tools

Pool

Lost Springs

POST REPORT

JAN 5 '56

Date Comm.

Cellar & pits

5

Use

No.

566



No. *County Map*

County Dickinson Elev. 1425 Co. 1425
 Sec. 35 Twp. 16 Rge. 4E
 Company Slusser Drilg.
 Farm Name Utech No. 3

TOPS

DEPTH

LOG

DATUM

Loc. in Sec.

Anh.

C E $\frac{1}{2}$ W $\frac{1}{2}$ SE

Tp.

H.

Tr.

Dg.

BL.

L.

K.C.

B.K.C.

Ce.

C.

M. *Chat**2276**851*

M.

K.

Mz.

Me.

V.

S.

S.

A.

R.

PE.

G.

T.D.

2287

Geol.

Contr.

Co. tools

Pool

Lost Springs

COMPLETE

Date Comm. 1-5-56

APR 25 1956

8 5/8" @ 101/50 5 1/2" @ 2287/25CO DD 2325 Comp. 10bopd 10 bw