

Lyon

Sec. 35 Twp. 16 R. 10E ✓

Well No. #1 Larson Farm

Stanolind Company

Contractor

Wildcat


330' Ft. from N. Line

Ft. from S. Line

330' Ft. from E. Line

Ft. from W. Line

NE NE NE

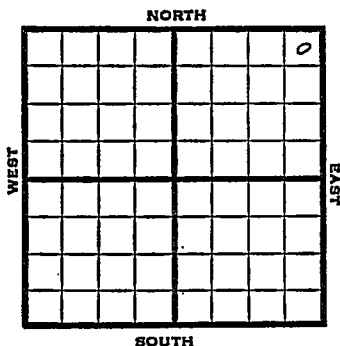

1951

Elev. 1343'

REPORT

4/18

Location

5/16

Spud 4-21-51

D & A TD 3220' 10" @ 140'

Lans. 1437' Miss 2453'

DST 2467-2527 open 1 hr. rec 93' mud
SO 2556-59'

DST 2547-78' open 1 hr. rec 140' WCM
Kinderhook 2868' Hunton 2947'

Cored 2949-56' rec 6' dol.

DST 2948-56 open 1 hr. rec 120' water
& SSO

DST 2956-65 open 1 hr. rec 64' SW

Maq. 2967' Viola 3039'

DST 3039-3122 open 1/2 hr. rec 2500' sul
water

Simp. dol. 3116'

Cored 3127-32

DST 3120-32 open 1 hr. rec 125' sul wtr

DST 3137-46 open 1/2 hr. rec 420' sul wtr

Arb. 3184'

DST 3184-3220 open 1/2 hr. rec 515' mud

TD 3220' D & A

ABANDONED

21/17

2453
1343
-1110

2947
2453
494


County Lyon State Kansas

Sec. 35 (Blk. Twp.) 16 (Sur. Rge.) 10E Map No.

Operator Stanolind

Well No. 1 Farm Larson

Elev. _____ Location NE NE NE

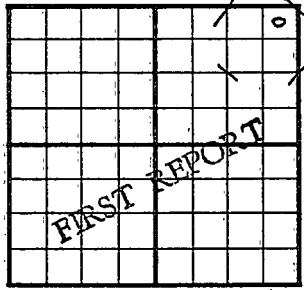

530 Ft. From N Line NE

330 Ft. From E Line Quarter

1st. Report APR 18 1951

Completion _____

Remarks _____

Spudding Date _____

Drlg. Data Wildcat

Location

