


Section 35 Township 16 Range 5E

Well No. 1 Miller

LARIAUX

Company Lario Oil & Ref. et al

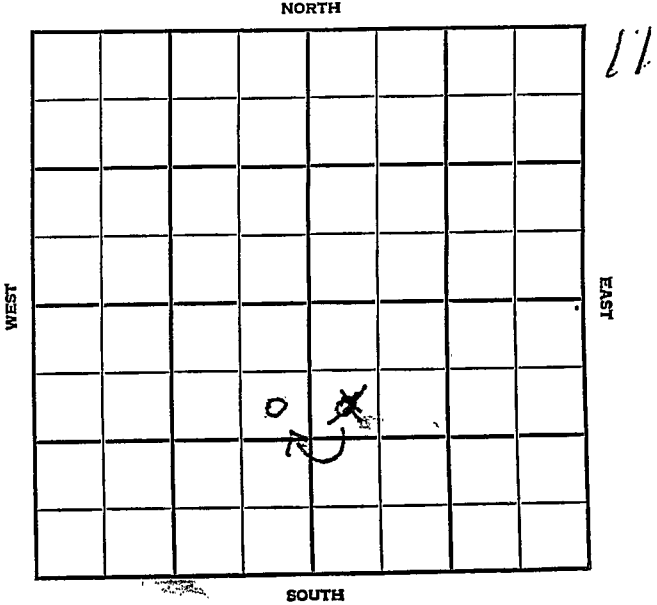

Kansas

Map No. _____ Sec. 35 Twp. 16 R. 5EWell No. 1 MillerLariaux

Company

CORRECTION

Contractor

SE NE SW


SECTION PLAT

990 Ft. from N. Line

_____ Ft. from S. Line

330 Ft. from E. Line

_____ Ft. from W. Line

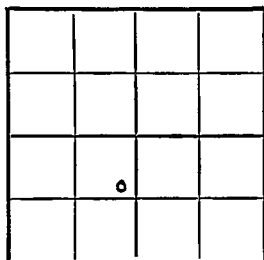

Morris
Marion County

Location _____

Rig up _____

Drilling and Remarks:

Reported

SW NW SE

RECORD

Cased _____ in., _____ ft.

Sand _____

Gas _____

Oil _____

Total Depth _____

PRODUCTION

1st 24 hrs. Nat. _____

1st 24 hrs. after shot _____

Gas _____ Cu. Ft.

Dry Hole _____


Abandoned _____

Date

OCT 6 1954 19

FABEN GILSTRAP

Scout

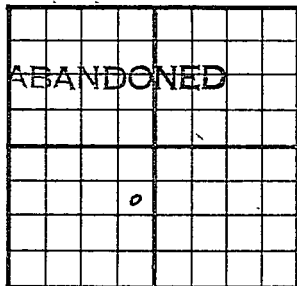County Morris State KansasSec. 35 (Blk.) 16 (Sur.) 5E Map No.Operator LariauxWell No. 1 Farm MillerElev. 1438 Location SE NE SW990 Ft. From N Line SW330 Ft. From E Line Quarter1st. ReportCompletion OCT 20 1954Remarks S. Creek PoolSlusser - Contr.Spudding Date 9-23-54Drlg. Data D & A TD 22908" @ 140 Miss. 2191 TD 2194 5" @ 2194DD 2290 S/ 1 bo 12 bw 2 hr. 100 AD & A

FABEN GILSTRAP