

Section 35 Township 16 Range 4 EWell No. # 1 BeelerCompany Slusser Drlg.

|  |  |  |  |  |  |  |  |
|--|--|--|--|--|--|--|--|
|  |  |  |  |  |  |  |  |
|  |  |  |  |  |  |  |  |
NORTH

WEST

EAST

SOUTH

0

13

Sec. 35 Twp. 16 R. 1 E

Well No. # 1 Beeler Farm

Slusser Drlg. Company

Slusser Drlg. Contractor

Lost Springs Pool


Ft. from N. Line

330 Ft. from S. Line

Ft. from E. Line

990 Ft. from W. Line

SE SW SW

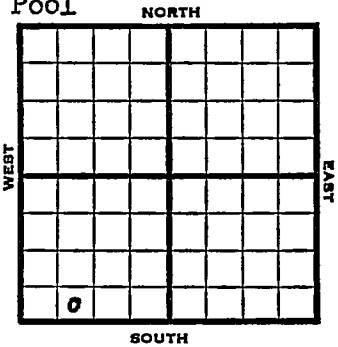


1953 Elev. 1143' REPORT

6/17 Location  
7/8 Spud 6-20-53  
Oil Well  
TD 2378'  
8" @ 92'  
Miss 2318'  
TD 2321'  
5" @ 2321'  
DD 2378 3 bopd sd-frac  
Comp. 15 bopd 15 bw.

COMPLETED

J. G. McGEHEE

County Dickinson State Kansas  
 Sec. 35 (Blk. 16) (Sur. 4E) (Twp.) Map No.  
 Operator Slusser Drlg.  
 Well No. 1 Farm Beeler  
 Elev. 1443 Location SE SW SW

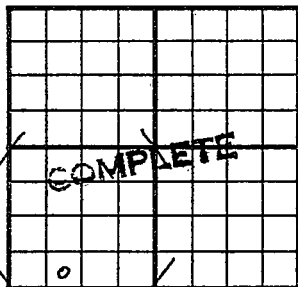

330 Ft. From S Line SW  
990 Ft. From W Line Quarter  
 Ist. Report  
 Completion JUL 8 1953  
 Remarks Lost Springs Pool  
Slusser Drlg. - Contr.  
 Spudding Date 6-20-53

Drlg. Data Oil well TD 2378  
8" @ 92 Miss. 2318 TD 2321 5" @ 2321  
DD 2378 3 bopd sd-frac  
Comp. 15 bopd 15 bw