


Dickinson

Form 51-5M-4-27-27423

Map No. KANSAS Sec. 35 Twp. 16 R. 4E

Well No. 1 - Utack Farm
Harwood & Winters Company

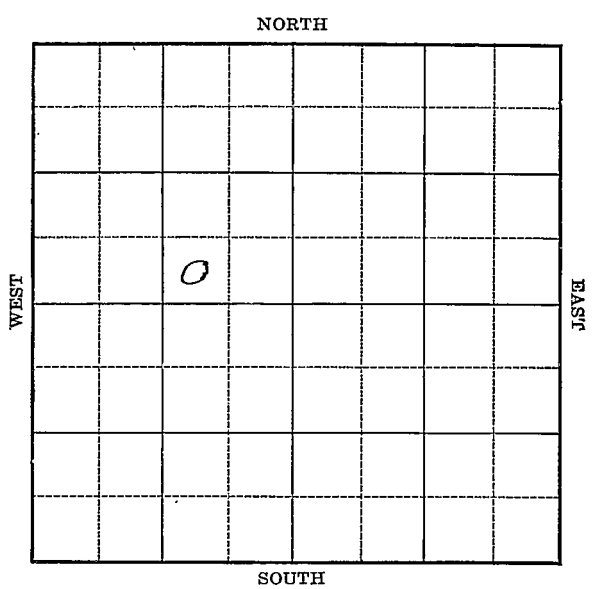

Location _____

Drilling Remarks _____

Rig Up _____

Drilling Remarks _____

RECORD

Cased _____ in. _____ ft.

Sand _____

Gas _____

Oil _____

Total Depth _____

PRODUCTION

1st 24 hrs. Nat. _____

1st 24 hrs. after shot _____

Gas _____ cu. ft.

Dry Hole _____

Abandoned _____

Dickinson

Map No. KANSAS Sec. 35 Twp. 16 R. 4E


Well No. 1- Uteck, Farm
Harwood & Winters Company

_____ Ft. from N. Line

330 Ft. from S. Line

990 Ft. from E. Line

_____ Ft. from W. Line

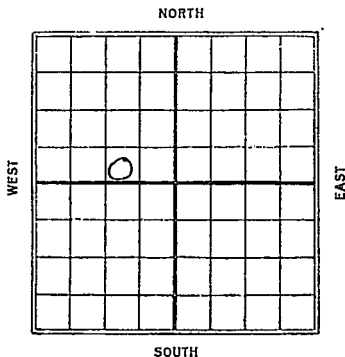

1927

Date	REPORT
------	--------

9/4	Location
9/19	—
10/6	—
10/12	—
10/19	Bldg rig
10/27	rigging up
11/2	Spudding
11/9	Drlg 400'
11/16	" 1365
11/23	S.D. 1600 for 10"
11/30	S.D. 1658 titles
12/7	—
12/14	—
12/21	—
12/29	—
1928	—
1/5	—
1/11	—
1/18	Drlg 1935.
1/26	Top chat 2275 - oil 2295-2305 in chat, 100' oil in hole
2/2	Base chat 2370 - drlg 2500.

1/9 - u.R. 5" - 2535-

2/16 - Top Sil. line 2548 - H.F.W.
drilling 2555-

2/23 - Chat 2275 - 2370 show
Top Sil. line 2548 - H.F.W.
D.A. 2601'

no map
KANSAS Sec. *35* Twp. *16* R. *4* *Diebinson E*

Well No. *1* *uteck*
Rawwood & Winters Company

Contractor

FIRST REPORTS

----- Ft. from N. Line
320 Ft. from S. Line
990 Ft. from E. Line
----- Ft. from W. Line

SECTION PLAT

	o		

Location -----
Rig up -----
Drilling and Remarks:

RECORD

Cased ----- in., ----- ft.
Sand -----
Gas -----
Oil -----
Total Depth -----

PRODUCTION

1st 24 hrs. Nat. -----
1st 24 hrs. after shot -----
Gas ----- Cu. Ft.
Dry Hole -----
Abandoned -----

Date
SEP 14 1927

CHAS. L. SHERWOOD

192

Scout

MO wall maps

Returned.....	
Cards.....
Tracing.....	<i>None</i>
France Map.....	
Scarborough Map.....
Moody Map.....	
Scarborough Plat Book.....	
Moody Plat Book.....	

Dickinson

Map No. *KANSAS* Sec. *35* Twp. *16* R. *4*

Well No. *1* *Utter*

Barwood & Winters Company

Contractor

COMPLETED

SECTION PLAT

----- Ft. from N. Line

330 Ft. from S. Line

990 Ft. from E. Line

----- Ft. from W. Line

ABANDONED

Location -----

Rig up -----

Drilling and Remarks:

Shot 2775, 2370 show

Top Silo lim 2548

DQg 2601

RECORD

Cased ----- in., ----- ft.

Sand -----

Gas -----

Oil -----

Total Depth *2601*

AFW PRODUCTION

1st 24 hrs. Nat. -----

1st 24 hrs. after shot -----

Gas ----- Cu. Ft.

Dry Hole

Abandoned

Date

FEB 23 1928

CHAS. L. SHERWOOD

192

Scout

no small map
no wall map

Returned	
Cards	_____
Trip Log	None
Trip Map	
Trip Budget Map	_____
Moody Men	
Scarboro. gl. et Book	62 K
Moody P't of Cook	

MAP NO. _____ SEC. 35 TWP. 16S R. 4E

WELL NO. 1 Utecke

Konwood-Miners COMPANY

no well map CONTRACTOR

SECTION PLAT

	o		

_____ FT. FROM N. LINE

_____ FT. FROM S. LINE

_____ FT. FROM E. LINE

_____ FT. FROM W. LINE

RECORD

LOCATION _____

CASED _____ IN., _____ FT.

RIG UP _____

SAND _____

DRILLING AND REMARKS:

GAS _____

OIL _____

TOTAL DEPTH 120'

PRODUCTION

1ST 24 HRS. NAT. _____

1ST 24 HRS. AFTER SHOT _____

GAS _____ CU. FT.

DRY HOLE ✓

ABANDONED _____

DATE

5/29 1928

SCOUT