

KANSAS


FORM 51 25M 3-49 PETROL

Morris

Section 36 Township 16 Range 5-E

Well No. #1 Johnson

Company Mendenhall Drlg.

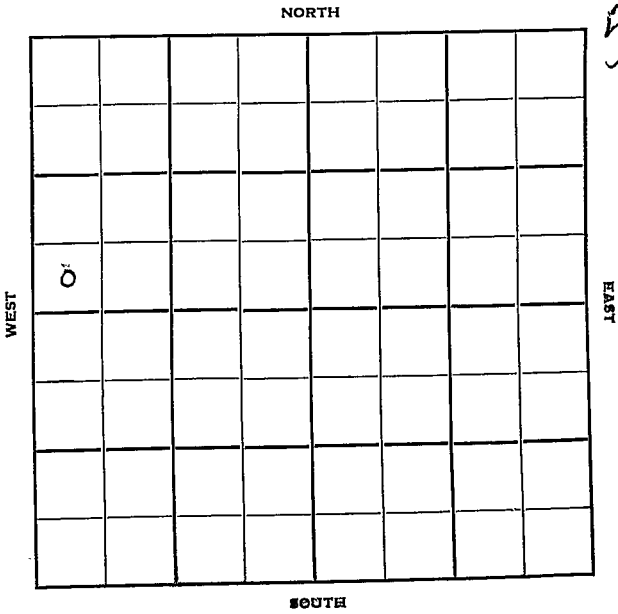

Morris

Sec. 36 Twp. 16 R. 5E ✓

Well No. #1 Johnson Farm

Mendenhall Drlg. Company

Contractor


_____ Ft. from N. Line

330' Ft. from S. Line

_____ Ft. from E. Line

330' Ft. from W. Line

SW SW NW

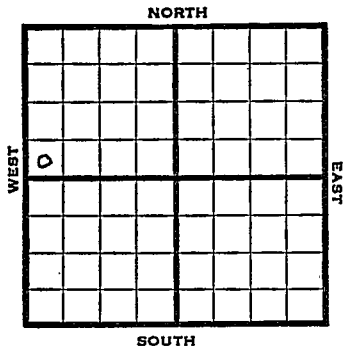

1950

Elev. 1451' REPORT

9/20

Location

1951

1/17

Spud 9-21-50
 D&A TD 2250
 8" @ 156' Miss Chat 2191-96
 5 1/2" @ 2193 TD 2228
 SSo 2203-07 2213-17
 DD 2250 PB 2230 40 qt/2201-30
 FU 350' oil 550' wtr 16 hr
 P/8 bopd D&A

ABANDONED

County Morris State Kansas

Sec. 36 (Blk. Twp.) 16 (Sur. Rge.) 5E Map No.

Operator Mendenhall, Drlg.

Well No. 1 Farm Johnson

Elev. _____ Location SW SW NW

0					

330 Ft. From S Line NW

330 Ft. From W Line Quarter

1st. Report SEP 20 1950

Completion _____

Remarks _____

Spudding Date _____

Drlg. Data 3 Mile Creek Pool

Location

County Morris State Kansas

Sec. 36 (^{Blk.}_{Twp.}) 16 (^{Sur.}_{Rge.}) 5E Map No.

Operator Mendenhall Drlg.

Well No. 1 Farm Johnson

Elev. 1451 Location SW SW NW

0	/				

330 Ft. From S Line NW

330 Ft. From W Line Quarter

Ist. Report

Completion JAN 17 1951

Remarks 3 mile creek Pool

Spudding Date 9-21-50

Drlg. Data D & A TD 2250

8" @ 156 Miss. chat 2191-96 5 1/2" @ 2193

TD 2228 SSO 2203-07 2213-17 DD 2250

PB 2230 40 qt/ 2201-30 FU 350' oil

550' water 16 hr. P/ 8 bopd

D & A