

Section 36 Township 16 Range 5EWell No. #3 CarlsonCompany Ring - Mac Oil

NORTH

WEST

EAST

SOUTH

13

0

Sec. 36 Twp. 16 R. 5E

Well No. #3 Carlson Farm

Ring - Mac Oil Company

Slusser Drlg. Contractor


 Ft. from N. Line

330 Ft. from S. Line

 Ft. from E. Line

330 Ft. from W. Line

SW SW SW

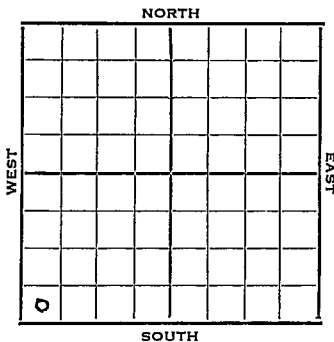

1952 Elev. 1433 REPORT

7/30 Spud 7-26-52
8" @ 134'
Drlg. 1439'

8/20 Spud 7-26-52
Oil Well TD 2206
8" @ 134 Miss 2184 TD 2187
5" @ 2187 DD 2206 P/100 bopd
Comp. 25 bopd

COMPLETED

County **Morris** State **Kansas**
 Sec. **36** (Blk. Twp.) **16** (Sur. Rge.) **5E** Map No.
 Operator **Ring - Mac Oil**
 Well No. **3** Farm **Carlson**
 Elev. Location **SW SW SW**

0							

330 Ft. From **S** Line **SW**

330 Ft. From **W** Line Quarter

1st. Report **JUL 30 1952**

Completion

Remarks

Slusser Drlg. - Contr.

Spudding Date **7-26-52**

Drlg. Data

8" @ 134 drlg. 1439

County Morris State Kansas

Sec. 36 (Blk. Twp.) 16 (Sur. Rge.) 5E Map No.

Operator Ring - Mac Oil

Well No. 3 Farm Carlson

Elev.	1433	Location	SW SW SW
-------	------	----------	----------

0

COMPLETE

330 Ft. From S Line SW

330 Ft. From W Line Quarter

1st. Report _____

Completion **AUG 20 1952**

Remarks

Slusser D.rlg. - Contr.

Spudding Date 7-26-52

Drlg. Data Oil well TD 2206

8" @ 134 Miss. 2184 TD 2187 5" @ 2187

DD 2206 P/ 100 bopd Comp. 25 bopd

J. G. MULLIEE