


Section 22 Township 16 Range 4-E

Well No. 1 Doyle "B" (later B-2)

Company International Oil

Lost Spring Pool NORTH

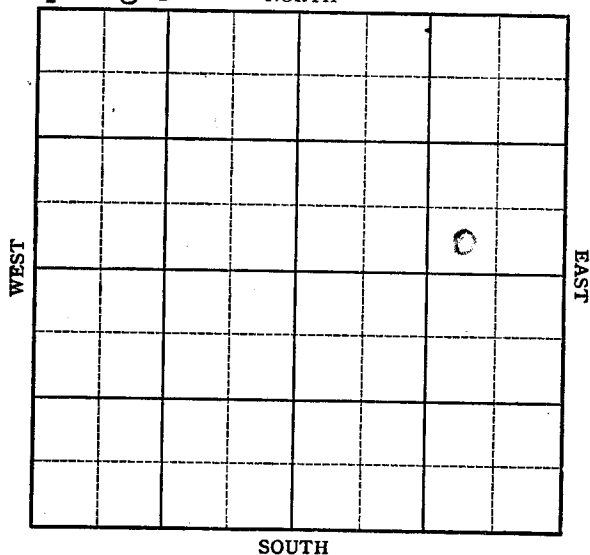

Sec. 22 Twp. 16 R. 4-E

Well No. #1 Doyle "B" Farm

International Oil Company
Lost Spring Pool

Ft. from N. Line

330


Ft. from S. Line

990

Ft. from E. Line

Ft. from W. Line

SW SE NE

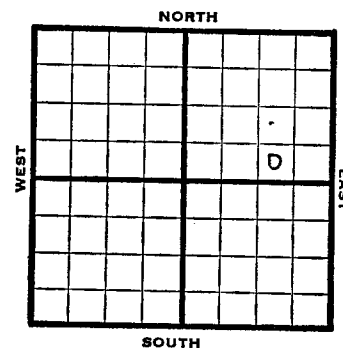

1947

Elev. 1398' REPORT

7/2

8" @ 120'
KC 1780
Miss. 2274'
TD 2278'
5" @ 2278'

7/8

"

7-16

TD 2318 HFW

7/23

Miss. 2274'
5" @ 2278'
T.D. 2322'
Abandoned

ABANDONED

Map No. 26 Sec. 22 Twp. 16 R. 4EWell No. 1 Doyle "B"International Oil CompanyABANDONED Contractor
SW SE NE E11898

SECTION PLAT

 Ft. from N. Line330 Ft. from S. Line990 Ft. from E. Line Ft. from W. Line

Dickinson County

Location Rig up

Drilling and Remarks:

Miss 22745" @ 2278

RECORD

Cased in., ft.Sand Gas Oil Total Depth 2322

PRODUCTION

1st 24 hrs. Nat. 1st 24 hrs. after shot Gas Cu. Ft.Dry Hole Abandoned

Date

JUL 23 1947 19 S. J. LEWIS ScoutMap No. Sec. 22 Twp. 16 R. 4EWell No. 1 Doyle "B"International Oil CompanyFIRST REPORT Contractor

SW SE NE

SECTION PLAT

 Ft. from N. Line330 Ft. from S. Line990 Ft. from E. Line Ft. from W. Line

Dickinson County

Location Rig up

Drilling and Remarks:

8" @ 120KC 1780Miss. 2274TD 22785" @ 2278

RECORD

Cased in., ft.Sand Gas Oil Total Depth

PRODUCTION

1st 24 hrs. Nat. 1st 24 hrs. after shot Gas Cu. Ft.Dry Hole Abandoned

Date

JUL 2 1947 19 S. J. LEWIS Scout