


KANSAS Morris

FORM 51 5M 11-44 PETROL

Section 5 Township 16 Range 5-E

Well No. #1 Stroda

Company Skelly

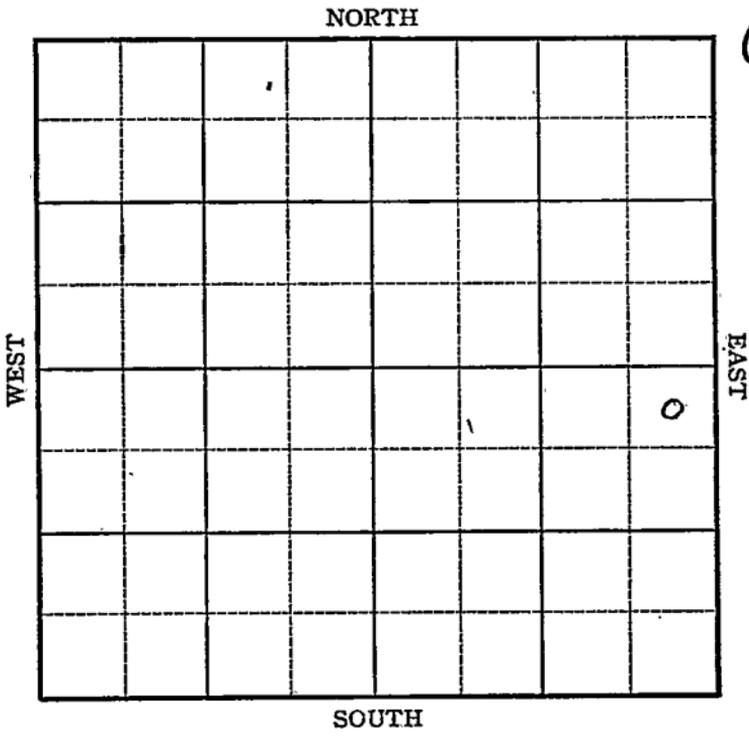

Sec. 5 Twp. 16 R. 5-E

Well No. #1 Stroda Farm


Skelly Company

330 Ft. from N. Line

_____ Ft. from S. Line

330 Ft. from E. Line

_____ Ft. from W. Line

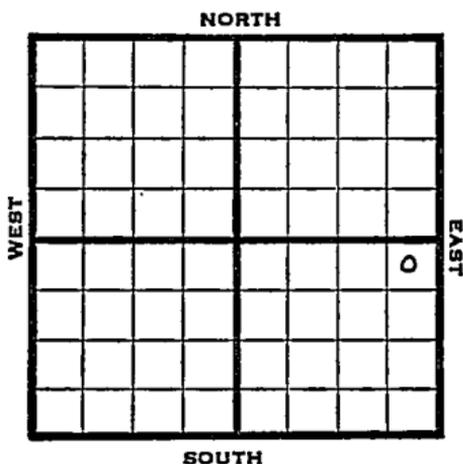

NE SE

1945 Elev. 1404' REPORT

- 12/5 Location
- 12/12 "
- 12/20 "
- 12/29 Cellar.
- 1946
- 1/10 Rig.
- 1/17 "
- 1/24 Drlg. 153'
- 1/31 15" - 133' Drlg. 810'
- 2/7 10" - 1238'
- Drlg. 1370'
- 2/14 7" - 1920' Drlg. 1926'
- 2/21 7" - 1955' Drlg. 1970'
- 2/28 Lans. 1685' B.K.C. 2015'
- Miss 2195-2196' UR 7".

- 3/6 Miss. 2201
- TD 2264'

2015
1404
-611

ABANDONED

KANSAS Pool Name ildcat

Map No. 11-26 Sec. 5 Twp. 16 R. 5E

Well No. 1 Stroda

Skelly Company
FIRST REPORT

Contractor _____

NE SE


SECTION PLAT

330 Ft. from N. Line

_____ Ft. from S. Line

330 Ft. from E. Line

_____ Ft. from W. Line

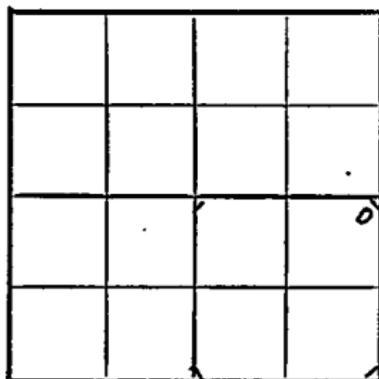

Morris County

Location x

Rig up _____

Drilling and Remarks:

RECORD

Cased _____ in., _____ ft.

Sand _____

Gas _____

Oil _____

Total Depth _____

PRODUCTION

1st 24 hrs. Nat. _____

1st 24 hrs. after shot _____

Gas _____ Cu. Ft.

Dry Hole _____

Abandoned _____

Date

DEC 5 1945

19

S. J. LEWIS

Scout

KANSAS Kansas Pool Name Wildcat

Map No. 26 Sec. 5 Twp. 16 R. 5E

Well No. 1 Stroda

Skelly Company

ABANDONED Contractor

E. 1404

NE SE

SECTION PLAT

330 Ft. from N. Line

_____ Ft. from S. Line

330 Ft. from E. Line

_____ Ft. from W. Line

			0

Morris County

Location _____

Rig up _____

Drilling and Remarks:

Miss 2201

RECORD

Cased 2 1/2 in. _____ ft.

Sand _____

Gas _____

Oil _____

Total Depth 2264

PRODUCTION

1st 24 hrs. Nat. _____

1st 24 hrs. after shot _____

Gas _____ Cu. Ft.

Dry Hole _____

Abandoned _____

Date

MAR 6 1946

S. J. LEWIS Scout