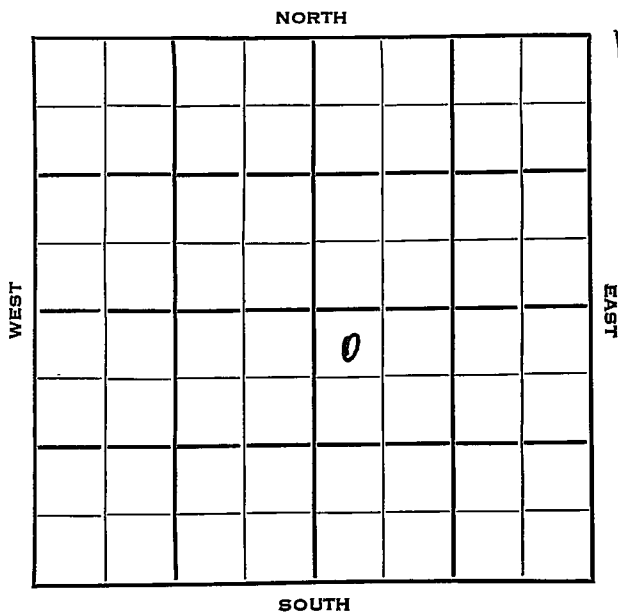


Section 5 Township 16 Range 4 EWell No. # 1 KeiningCompany ElDorado Ref.

Dickinson

KANSAS ✓

Sec. 5 Twp. 16 R. 1E

Well No. #1 Keining Farm

Eldorado Ref. Company

Slusser Drlg. Contractor

Wildcat.


330 Ft. from N. Line

_____ Ft. from S. Line

_____ Ft. from E. Line

330 Ft. from W. Line

NW NW SE

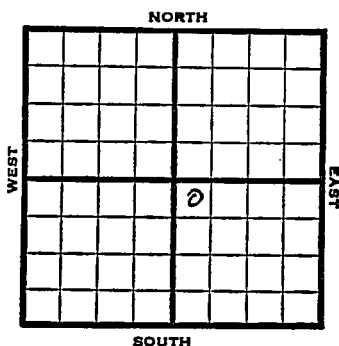

1953

Elev. 1354'

REPORT

6/3

Loc.

7/1

Spud 6-10-53 D & A TD 2313
8" @ 114 Miss 2273 TD 2282
Cong. 2268 5" @ 2275 GO to 2282
100' wtr. DD 2293 wtr. DD 2309
DD 2313 4 BWPH
D & A

ABANDONED

2273
1354
919

County **Dickinson** State **Kansas**
 Sec. **5** (Blk.) **16** (Sur.) **4E** Map No.
 Operator **Eldorado Ref.**
 Well No. **1** Farm **Keining**
 Elev. Location **NW NW SE**

-							


330 Ft. From **N** Line **SE**
330 Ft. From **W** Line Quarter
 1st. Report **JUN 3 1953**
 Completion
 Remarks
Slusser Drlg. - Contr.
 Spudding Date

Drlg. Data

Wildcat**Location**

J. G. McGEHEE

County Dickinson State Kansas
 Sec. 5 (Blk.) 16 (Sur.) 4E Map No.
 Operator Eldorado Ref.
 Well No. 1 Farm Keining
 Elev. 1354 Location NW NW SE

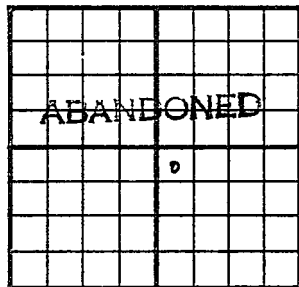

330 Ft. From N Line SE
330 Ft. From W Line Quarter
 1st. Report
 Completion JUL 1 1953
 Remarks Wildcat
Slusser Drlg. - Contr.
 Spudding Date 6-10-53

Drlg. Data D & A TD 2313
8" @ 144 Miss. 2273 TD 2282 Cong. 2268
5" @ 2275 CO to 2282 100' wtr.
DD 2293 wtr. DD 2309 DD 2313
4 bwph

D & A

J. G. McGEHEE