

Map No. **KANSAS** Sec. **6** Twp. **16 R. 6 E**


Well No. **1 - Scott** Farm
Thad O'Day Company

330 Ft. from N. Line

_____ Ft. from S. Line

330 Ft. from E. Line

_____ Ft. from W. Line

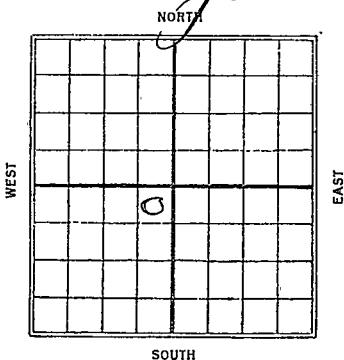

1928

Date

REPORT

7/13 Loc.

7/19 —

7/26 —

8/2 —

8/9 —

8/16 —

8/22 Aband Loc

Morris

Norman

MAP NO. *Konzo* SEC. *6* TWP. *16* R. *6^E*

WELL NO. *1* *Scott*

Thad O'Day

COMPANY

CONTRACTOR

SECTION PLAT

FIRST REPORTS

330 FT. FROM N. LINE

FT. FROM S. LINE

330 FT. FROM E. LINE

FT. FROM W. LINE

	<i>0</i>		

LOCATION

RIG UP

DRILLING AND REMARKS:

RECORD

CASED _____ IN. _____ FT.

SAND _____

GAS _____

OIL _____

TOTAL DEPTH _____

PRODUCTION

1ST 24 HRS. NAT. _____

1ST 24 HRS. AFTER SHOT _____

GAS _____ CU. FT.

DRY HOLE _____

ABANDONED _____

DATE

7/13/28

192

Sherwood

SCOUT

Morris

No. 2
 MAP NO. KANSAS SEC. 6 TWP. 16 R. 6

WELL NO. 1 *Scott*
Thos O'Day COMPANY

CONTRACTOR

COMPLETED

SECTION PLAT

	0		

330 FT. FROM N. LINE

_____ FT. FROM S. LINE

330 FT. FROM E. LINE

_____ FT. FROM W. LINE

ABANDONED

LOCATION _____

RIG UP _____

DRILLING AND REMARKS:

Location

RECORD

CASED _____ IN. _____ FT.

SAND _____

GAS _____

OIL _____

TOTAL DEPTH 55

PRODUCTION

1ST 24 HRS. NAT. _____

1ST 24 HRS. AFTER SHOT _____

GAS _____ CU. FT.

DRY HOLE Location

ABANDONED _____

DATE

AUG 22 1928

CHAS. L. SHERWOOD

192

SCOUT