

2-16-7E


WELL LOG BUREAU KANSAS GEOLOGICAL SOCIETY
508 E. Murdock, Wichita, Kansas

Company - C. W. BRACKENSICK
Farm - Alexander No. 1

SEC. 2 T. 16 R. 7E
SW SW SW

Total Depth. 630
Comm. 1-2-50
Shot or Treated.
Contractor.
Issued. 3-18-50

Comp. 1-14-50 ✓

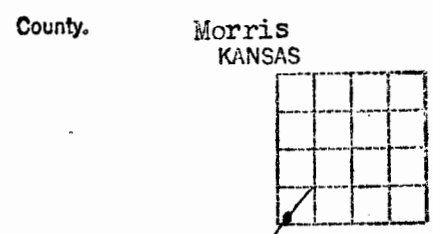

Elevation. _____

Production. dry

CASING:

6" 202'

Figures Indicate Bottom of Formations.

soil	2	shale lt	447
clay red	6	shale gr	454
lime, shale	18	shale drk	464
red rock	27	shale blk	468
lime	39	shale lt	477
shale blue	54	shale gr	480
lime sft	77	shale drk	484
shale gr	79	shale gr	500
red rock	83	shale drk	505
lime	92	shale gr	510
shale blue	96	shale blue	514
shale gr	112	shale gr	529
lime	114	shale drk	535
shale gr	122	shale lt	541
shale drk	124	shale blue	546
lime	127	shale lt	595
shale drk	136	shale blue	607
shale gr	150	shale gr	630
lime	152	Total depth	
shale drk	159		
lime	161		
shale gr	166		
lime	170		
shale drk	173		
lime	175		
shale gr	185		
lime	191	shale lt hrd	341
shale drk	195	shale drk	355
shale gr	202	shale gr	362
shale hrd	207	shale lt	377
shale gr	212	shale gr	385
red rock	218	shale lt	393
shale gr	220	shale gr	400
lime	222	shale lt	413
shale gr	226	shale blue	423
red rock	232	shale sd	424
lime sft	252	shale gr	425
shale blue	256	shale lt	432
shale lgt hrd	297	shale gr	435
lime	301		
shale drk	313		
shale gr	332		