

P2 Fred


As allowed under Rule 82-2-125

KANSAS

WELL COMPLETION REPORT AND DRILLER'S LOG

API No. 15 — 127 County — 20,358 Number

S. 22 T. 16S R. 8 E
 Loc. 50' E of C E $\frac{1}{2}$ E $\frac{1}{2}$ W $\frac{1}{2}$
 County Morris

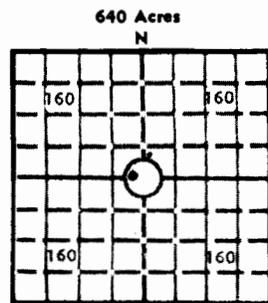

Locate well correctly
 Elev.: Gr. 1309'
 DF _____ KB 1313'

Operator
 Pendleton Land and Exploration, Inc.

Address
 23 Inverness Way East, Englewood, CO 80112

Well No. 1 Lease Name Scholes

Footage Location
2640 feet from (N) line 2360 feet from (W) line

Principal Contractor Silverado Drilling Rig #10 Geologist Dave Flinn

Spud Date 7/21/81 Date Completed 8/08/81 Total Depth 3007' P.B.T.D. _____

Directional Deviation _____ Oil and/or Gas Purchaser _____

CASING RECORD

Report of all strings set — surface, intermediate, production, etc.

Purpose of string	Size hole drilled	Size casing set (in O.D.)	Weight lbs/ft.	Setting depth	Type cement	Sacks	Type and percent additives
Surface	10 3/4	8 5/8	24#	166	COMMON	70	2% cc

LINER RECORD

PERFORATION RECORD

Top, ft.	Bottom, ft.	Sacks cement	Shots per ft.	Size & type	Depth interval

TUBING RECORD

Size	Setting depth	Packer set at

ACID, FRACTURE, SHOT, CEMENT SQUEEZE RECORD

Amount and kind of material used	Depth interval treated
Plugged: @ 180' w/ 38 sx	
@ 60' w/ 40 sx	
5 sx in rat hole	

INITIAL PRODUCTION

Date of first production _____ Producing method (flowing, pumping, gas lift, etc.) _____

RATE OF PRODUCTION PER 24 HOURS	Oil	Gas	Water	Gas-oil ratio
	bbls.	MCF	bbls.	CFPB
Disposition of gas (vented, used on lease or sold) _____			Producing interval (s) _____	

INSTRUCTIONS: As provided in KCC Rule 82-2-125, within 90 days after completion of a well, one completed copy of this Drillers Log shall be transmitted to the State Geological Survey of Kansas, 4150 Monroe Street, Wichita, Kansas 67209. Copies of this form are available from the Conservation Division, State Corporation Commission, 245 No. Water, Wichita, Kansas 67202. Phone AC 316-522-2206. If confidential custody is desired, please note Rule 82-2-125. Drillers Logs will be on open file in the Oil and Gas Division, State Geological Survey of Kansas, Lawrence, Kansas 66044.

DESIGNATE TYPE OF COMP.: OIL, GAS, DRY HOLE, SWDW, ETC.:

Operator
Pendleton Land and Exploration, Inc.

Well No. 1 Lease Name Scholes

dry hole

S 22 T 16S R 8 E

WELL LOG

Show all important zones of porosity and contents thereof; cored intervals, and all drill-stem tests, including depth interval tested, cushion used, time tool open, flowing and shut-in pressures, and recoveries.

SHOW GEOLOGICAL MARKERS, LOGS RUN, OR OTHER DESCRIPTIVE INFORMATION.

FORMATION DESCRIPTION, CONTENTS, ETC.	TOP	BOTTOM	NAME	DEPTH
<p>DST #1: 2968-2977/Viola/30"33"60"60" Rec 65' OSMW w/ S00 of top of tool. IHP 1461, IFP plugged-42, ISIP 962, FHP 1461, FFP 45-75, FSIP 960, BHT 109°F.</p>			E-log tops:	
			Lansing BKC Cherokee Miss Kh Hunton Mq Viola	1531 (- 218) 1898 (- 585) 2131 (- 818) 2441 (-1128) 2660 (-1347) 2817 (-1504) 2898 (-1585) 2973 (-1660)
			Logs run:	
			BHCS BHCS IES	0-1590 173-3001 173-3006

USE ADDITIONAL SHEETS, IF NECESSARY, TO COMPLETE WELL RECORD.

Date Received



Lee Brian VanRamshorst
Manager of Operations

Title

10/20/81

Date