

No County Map

County **Morris** Elev. _____
 Sec. **13** Twp. **16** Rge. **9E**
 Company **Kuper Oil**
 Farm Name **Porter** No. **1**

TOPS	DEPTH	LOG	DATUM	Loc. in Sec.
				C E 1/2 SWSW
Anh.				
Tp.				
H.				
Tr.				
Dg.				
BL				
L.				Geol. _____
K.C.				Contr. _____
B.K.C.				Capitt
Ce.				Pool _____
C.				
M.				
M.				
K.				
Mz.				
Me.				
V.				
S.				
S.				
A.				
R.				
PE.				
G.				

Geol. _____
 Contr. _____
 Pool _____

FIRST REPORT

MAY 23 56

Date Comm. **5-17-56**
 8 5/8" @ 145 drlg. 2685

T
I
R

County **Morris** Elev. **1245 KB**
 Sec. **13** Twp. **16** Rge. **9E**
 Company **Kuper Oil**
 Farm Name **Porter** No. **1**

TOPS	DEPTH	LOG	DATUM	Loc. in Sec.
				C E 1/2 SWSW
Anh.				
Tp.				
H.				
Tr.				
Dg.				
BL				
L.				Geol. _____
K.C.				Contr. _____
B.K.C.				Capitt
Ce.				Pool _____
C.				
M.				
M.				
K.				
Mz.				
Me.				
V.				
S.				
S.				
A.				
R.				
PE.				
G.				

Geol. _____
 Contr. _____
 Pool _____

COMPLETE



JUL 31 1956

Date Comm. **5-17-56**
 8 5/8" @ 145 drlg. 2685

3/2 @ 2742/100 JUN 6 56
 CO. of 4/ 2920-21 FU 2300'
 12 1/2" @ 2742/100 JUN 13 56 JUN 20 56
 R. of 19/ 2920-22 FU 2300'
 12 1/2" @ 2742/100 JUN 27 56 P 45
 R. of 19/ 2920-22 FU 2300'

SEC. 13 TWP. 16 R. 9E
 WELL NO. #1 Porter FARM
 COMPANY Kuper Oil
 CONTRACTOR Capitt

SECTION 13 TOWNSHIP 16 RANGE 9E
 WELL NO. #1 Porter
 COMPANY Kuper Oil

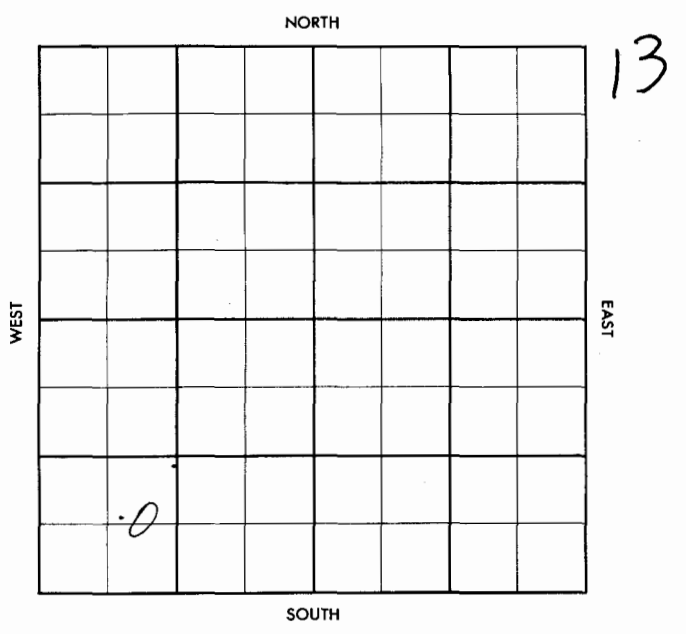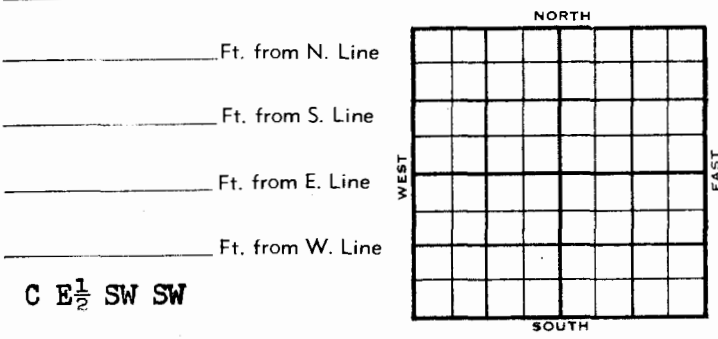

1956	ELEVATION	REPORT
	1245 KB	
5-23	Comm. 5-17-56 8 5/8" @ 145 Drlg. 2685	
7-3	5 1/2" @ 2969 w/100 Pf. 4/ 2920-21, FU 800' oil, 12 hrs. Re-Pf. 18/2920-22, FU 2300' oil, 8 hrs. P/ 45 bood, no/wtr. M. 2383', Hunt 2795', Mq, 2844', V. 2918', TD 2970'	
COMPLETED		
$\begin{array}{r} 2795 \\ 2383 \\ \hline 412 \end{array}$		

DX-78