

No County Map

County Morris Elev. 1268

Sec. 23 Twp. 16 Rge. 9E

Company Dralte

FarmName Lee No. 2

TOPS	DEPTH	LOG	DATUM	Loc. in Sec.
Anh.				NW SW SE
T.P.				
H.	<u>1142</u>			
Tr.				
Dg.				
Bl.				
L.	<u>1421</u>		<u>153</u>	Geol.
K.C.	<u>1560</u>		<u>292</u>	Contr.
B.K.C.	<u>1813</u>		<u>545</u>	
Ce.				
C.				
M.	<u>2403</u>		<u>1135</u>	Pool
M. <u>Hunter</u>	<u>2480</u>		<u>1212</u>	
K. <u>B. Hunter</u>	<u>2916</u>		<u>1648</u>	
Mz.				
Mo.				
V.				
S.	<u>2986</u>		<u>1718</u>	
A.				
R.				
Pe.				
G.				
TD.	<u>2988</u>			

ABANDONED

Date Comm. 10-19-55 MAR 21 1956

8 5/8" @ 175 5 1/2" @ 2987 CO to 2988

250 A FU 300' oil 2100' wtr. 12 hr.

P/ 12 bo DD 2994 FU 2900' fluid

1 1/4 hr. P/ 30 bopd 1280 bw

D & A

No County Map

County Morris Elev. 1268

Sec. 23 Twp. 16 Rge. 9E

Company Dralte

FarmName Lee No. 2

TOPS	DEPTH	LOG	DATUM	Loc. in Sec.
Anh.				NW SW SE
T.P.				
H.				
Tr.				
Dg.				
Bl.				
L.				Geol.
K.C.				Contr.
B.K.C.				
Ce.				
C.				
M.				Pool
M.				
K.				
Mz.				
Mo.				
V.				
S.				
A.				
R.				
Pe.				
G.				
TD.				

OCT 19-1955
FIRST REPORT

Date Comm. Location

Morris

KANSAS

Morris

KANSAS

SEC.	23	TWP.	16	R.	9E
WELL NO. #2 Lee					
FARM					
COMPANY					
Dralte					
CONTRACTOR					


_____ Ft. from N. Line

_____ Ft. from S. Line


_____ Ft. from E. Line

_____ Ft. from W. Line

NW SW SE

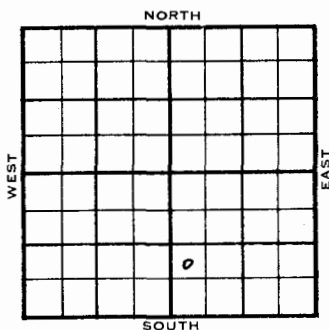

SECTION	23	TOWNSHIP	16	RANGE	9 E
WELL NO. #2 Lee					
COMPANY Dralte					

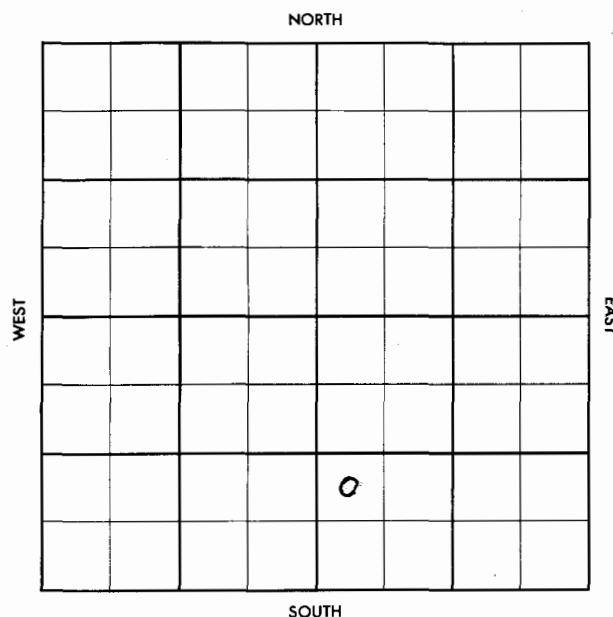

1955	ELEVATION	REPORT
10/19	1268	Loc
1956		
3-21	Comm. 10-19-55 8 5/8" @ 175 5 1/2" @ 2987 CO to 2988 250 A Fu 300' oil, 2100' wtr., 12 hrs. P/ 12 bo DD 2994 FU 2900' fluid 1 1/4 hrs., P/ 30 bopd, 1280 bw D & A H. 1142 L. 11421 KC 1560 BKC 1813 M. 2403 Hunton 2430 B. Hunton 2916 S. 2986 TD 2988'	

ABANDONED

DX-78