

Franklin

Form 51-5M-2-29-34703

Map No. KANSAS

Sec. 9

Twp. 16

R. 18<sup>E</sup>

Well No. 1-1

Robbins

Farm

Hayhurst & Smith

Company

NORTH

WEST

EAST

SOUTH

14

0

Location

Drilling Remarks

Rig Up

Drilling Remarks

RECORD

Cased in. ft.

Sand

Gas

Oil

Total Depth

PRODUCTION

1st 24 hrs. Nat.

1st 24 hrs. after shot

Gas cu. ft.

Dry Hole

Abandoned


Franklin

Map No. KANSAS Sec. 9 Twp. 16 R. 18E

Well No. 1- Robbins Farm

Haghurst & Smith Company

NORTH

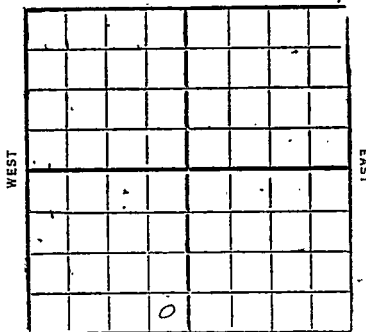

Ft. from N. Line

250 Ft. from S. Line

250 Ft. from E. Line

Ft. from W. Line

1931

SOUTH

Date

REPORT

6/3 Show gas 1075-77  
dry sand 1084-90  
" " 1107-15  
HFW 1115-49  
T.D. 1149  
Dry & Abandon

Map No. **KANSAS** Sec. **9** Twp. **16** R. **18<sup>E</sup>**  
 Well No. **1** **Robbins**

**Hayhurst & Smith** Company

Contractor

**FIRST REPORTS**  
*and*  
**COMPLETED**

**SECTION PLAT**

|  |  |  |  |
|--|--|--|--|
|  |  |  |  |
|  |  |  |  |
|  |  |  |  |
|  |  |  |  |
|  |  |  |  |

Ft. from N. Line

**750** Ft. from S. Line

**750** Ft. from E. Line

Ft. from W. Line

Location

Rig up

Drilling and Remarks:

Shaw gas 1075-77

Dry Sand 1084-90

" " 1107-15

HFW 1115-49

D+9

**RECORD**

Cased in., ft.

Sand

Gas

Oil

Total Depth **1149**

**PRODUCTION**

1st 24 hrs. Nat.

1st 24 hrs. after shot

Gas Cu. Ft.

Dry Hole ☒

Abandoned ☒

Date

**JUN 3 1931**

**CHAS. L. SHERWOOD**

192 Scout