

KANSAS


FORM 51 5M PETROL

Marion

Section 1 Township 17 Range 2E

Well No. #1 Stegeman

Company Westgate-Greenland

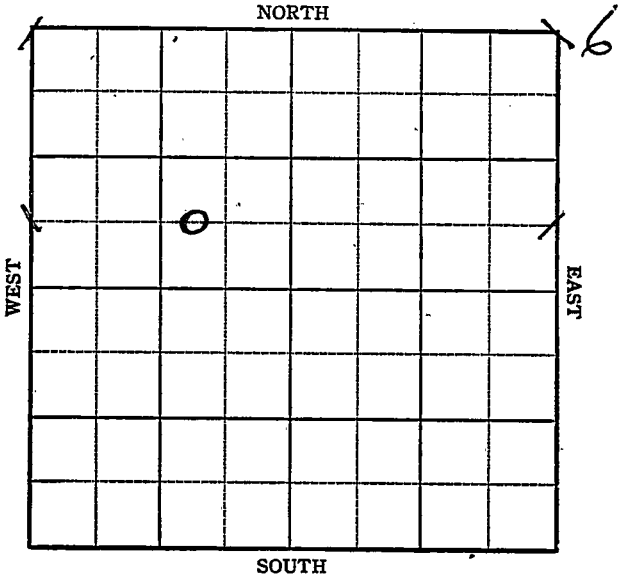


KANSAS

Marion

Sec. 1 Twp. 17 R. 2-E

Well No. #1 Stegeman Farm
Westgate-Greenland Company

NORTH

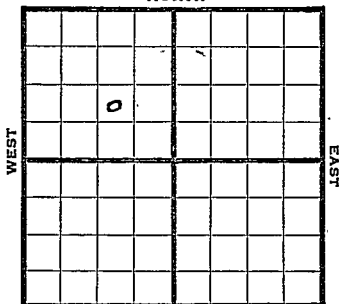

_____ Ft. from N. Line

660 Ft. from S. Line

990 Ft. from E. Line

_____ Ft. from W. Line

Wildcat

REPORT

1944

3/15 Location.

3/22 "

3/29 "

4/5 10" @ 120
Drlg. 1605

4/12 Miss 2484
Drlg. 3018

4/19 Viola 3035
TD 3100

3035
2484

551

ABANDONED

KANSAS

Map No. 25 Sec. 1 Twp. 17 R. 2E

Well No. 1 Stegeman

Westgate-Greenland Company

FIRST REPORT Contractor

C W L SE NW

SECTION PLAT

_____ Ft. from N. Line

660 Ft. from S. Line

990 Ft. from E. Line

_____ Ft. from W. Line

Wildcat

Location X

Rig up _____

Drilling and Remarks:

RECORD

Cased _____ in., _____ ft.

Sand _____

Gas _____

Oil _____

Total Depth _____

PRODUCTION

1st 24 hrs. Nat. _____

1st 24 hrs. after shot _____

Gas _____ Cu. Ft.

Dry Hole _____

Abandoned _____

Date

MAR 15 1944 19

S. J. LEWIS Scout

Pool Name Wildcat

KANSAS

Map No. _____ Sec. 1 Twp. 17 R. 2E

Well No. 1 Stegeman

Westgate-Greenland Company

ABANDONED Contractor

C W L SE NW

SECTION PLAT

_____ Ft. from N. Line

660 Ft. from S. Line

990 Ft. from E. Line

_____ Ft. from W. Line

Marion County

	o		

Location _____

Rig up _____

Drilling and Remarks:

Via 3085

RECORD

Cased _____ in., _____ ft.

Sand _____

Gas _____

Oil _____

Total Depth 3100

PRODUCTION

1st 24 hrs. Nat. _____

1st 24 hrs. after shot _____

Gas _____ Cu. Ft.

Dry Hole _____

Abandoned _____

Date

APR 19 1944 19

S. J. LEWIS Scout