

KANSAS


FORM 51 5M- BRIX

Marion County

Section 10 Township 17 Range 4E

Well No. #1 W. A. Martin

Company R. E. Vonker

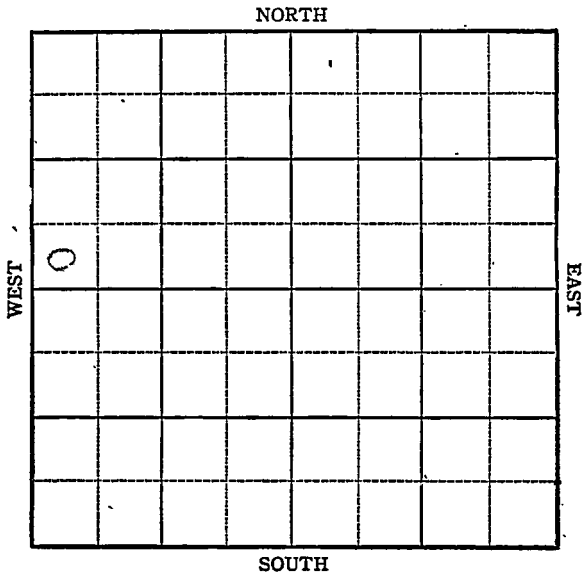


KANSAS Marion County

Sec. 10 Twp. 17 R. 4E

Well No. #1 W. A. Martin Farm

R. E. Yonker Company

Lost Spring

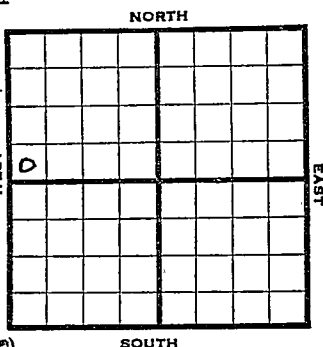

_____ Ft. from N. Line

330 Ft. from S. Line

_____ Ft. from E. Line

330 Ft. from W. Line

SW. NW Elev. 1428

1944

R E P O R T

9/27 Location

10/4 "

10/11 "

10/18 "

10/28 Cable rig

11/2 "N "

11/8 13" @ 105

Drlg. 155

11/16 Drlg. 1015

10" @ 940'

11/24 Drlg. 1675

11/29 Drlg. 1905

12/6 8" @ 1650'

6" @ 1750'

Drlg. 2152'

12/14 Miss 2327

5" @ 2327

TD 2347

1200' oil 20 hrs.

12/20 Miss 2327

5" @ 2327

TD 2376

Pump 150 pot

Grav.tiy 36.7

COMPLETED

KANSAS

Pool Name Lost SpringMap No. 26 Sec. 10 Twp. 17 R. 4EWell No. 1. W. A. MartinR. E. Yonker Company

FIRST REPORT Contractor

SW NW

SECTION PLAT

Ft. from N. Line

330 Ft. from S. Line

Ft. from E. Line

330 Ft. from W. Line

Marion

RECORD

Location X

Cased _____ in., _____ ft.

Rig up _____

Sand _____

Drilling and Remarks:

Gas _____

Oil _____

Total Depth _____

PRODUCTION

1st 24 hrs. Nat. _____

1st 24 hrs. after shot _____

Gas _____ Cu. Ft.

Dry Hole _____

Abandoned _____

Date

SEP 27 1944 19

S. J. LEWIS Scout

no wall map

Misc. Small Maps	<i>Resid</i>
Cards	<i>City</i>
Tracing	<i>M.L.</i>
France Map	
Scarborough's Map	<i>Resid</i>
Moody Map	
Geological Dept.	
Moody Plat Book	

Pool Name Lost SpringMap No. 26 Sec. 10 Twp. 17 R. 4EWell No. 1 W.A. MartinR.E. Youker CompanyCOMPLETED Contractor

SW NW

SECTION PLAT

 Ft. from N. Line330 Ft. from S. Line Ft. from E. Line330 Ft. from W. Line

MarionLocation Rig up

Drilling and Remarks:

Miss 23275' @ 2327Prod 150 Bbl.36² Gr

RECORD

Cased in., ft.Sand Gas Oil Total Depth 2376

PRODUCTION

1st 24 hrs. Nat. 1st 24 hrs. after shot Gas Cu. Ft.Dry Hole Abandoned

Date

DEC 20 1944 19S. J. LEWIS Scout

no wall map

Misc. Small Maps	<i>LR</i>
Cards	<i>LR</i>
Tracing	<i>LR</i>
France Map	<i>✓</i>
Scarborough Map	<i>LR</i>
Pierce Map	<i>✓</i>
Geological Dept.	
Pierce Flat Book	