


Marion

Form 51-5M-11-31-Palace

Map No. **KANSAS** Sec. 11 Twp. 17 R. 4 E

Well No. 2 Cowman Farm
Harwood Oil Co + Franco Oil Co Company

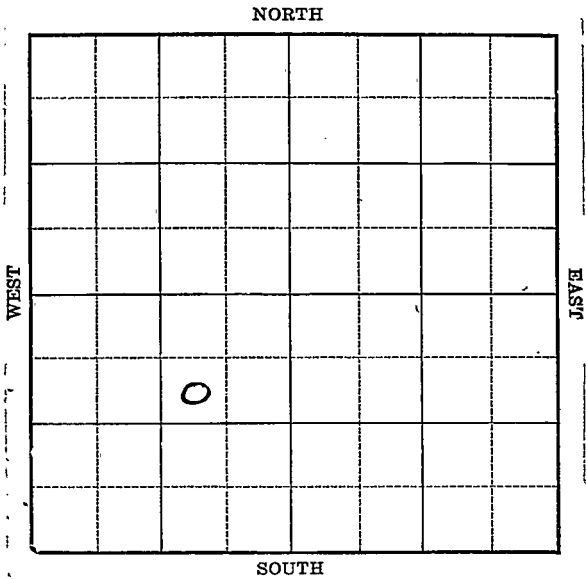

Location _____

Drilling Remarks _____

Rig Up _____

Drilling Remarks _____

RECORD

Cased _____ in. _____ ft.

Sand _____

Gas _____

Oil _____

Total Depth _____

PRODUCTION

1st 24 hrs. Nat. _____

1st 24 hrs. after shot _____

Gas _____ cu. ft.

Dry Hole _____

Abandoned _____

Marion

Map No. **KANSAS** Sec. 11 Twp 17 R. 4^E

Well No. 2 Cowman Farm


Narwood Oil Co or Franco Oil Co. Company

990 Ft. from N. Line

 Ft. from S. Line

990 Ft. from E. Line

 Ft. from W. Line

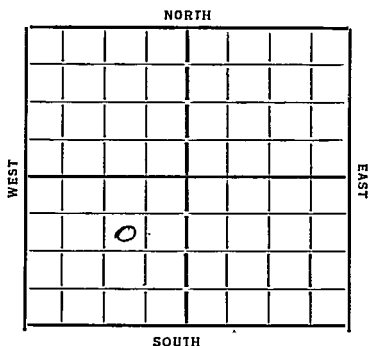

Date 7/23/4

REPORT

3/28 B. R.
4/5 Rign up
4/12 Dlg 615
4/19 " 1315
4/26 Run 8" 1685
5/3 Dlg 2140 8" 1698
5/10 " 2255 6" 2246
5/16 Chrt 2340 TD 2375
Pump 282 Bbls.

COMPLETED

Map No. 26 Sec. 11 Twp. 17 R. 4 E

Well No. 2 - Cowman
Harwood Oil & Frac. Co. Inc. Company

Contractor

FIRST REPORTS

SECTION PLAT

990 Ft. from N. Line
..... Ft. from S. Line
990 Ft. from E. Line
..... Ft. from W. Line

	0		

Location.....
Rig up.....
Drilling and Remarks:

BR

RECORD

Cased..... in., ft.
Sand.....
Gas.....
Oil.....
Total Depth.....

PRODUCTION

1st 24 hrs. Nat.....
1st 24 hrs. after shot.....
Gas..... Cu. Ft.
Dry Hole.....
Abandoned.....

Date

3-28-34

192

O. Marnescheck
Scout

Map No. 26 Sec. 11 Twp. 17 R. 4E

Well No. 2 - Cowman

Harwood Oil & Mineral Company

Contractor

COMPLETED

SECTION PLAT

990 Ft. from N. Line

_____ Ft. from S. Line

990 Ft. from E. Line

_____ Ft. from W. Line

Location _____

Rig up _____

Drilling and Remarks:

Ramp 282
pph

RECORD

Cased _____ in., _____ ft.
 Sand Chat 2340
 Gas _____
 Oil _____
 Total Depth 2375

PRODUCTION

1st 24 hrs. Nat. _____
 1st 24 hrs. after shot _____
 Gas _____ Cu. Ft.
 Dry Hole _____
 Abandoned _____

Date _____

5-16-37 19

ANN SCHRECK

Scout