




Marion

Map No. KANSAS Sec. 11 Twp. 17 R. 4<sup>E</sup>

Well No. 3 Cowman Farm  
Harwood et al Company

\_\_\_\_\_ Ft. from N. Line  
1070 Ft. from S. Line  
1070 Ft. from E. Line  
\_\_\_\_\_ Ft. from W. Line

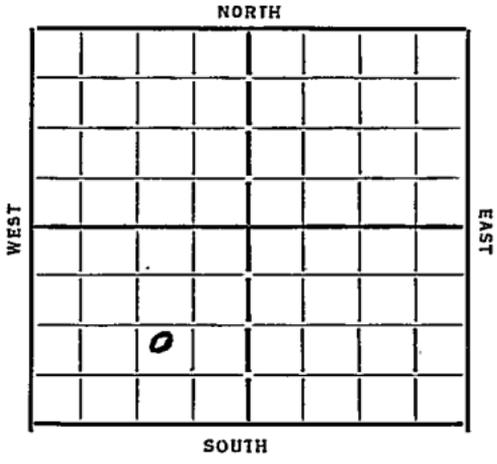

Date  
1934

REPORT

6/13 Rig  
6/21  
6/28 dy 380 12" 67  
7/5 " 1040  
7/12 " 1535 A796 1345 10" 1362  
7/19 dy 2070  
7/26 " 2345  
8/2 T Chat 2343 5" 2348  
S.O. 2362  
8/9 T 2378 700' oil P.B.P.  
8/16 Testing  
8/22 Chat 2343 T 2378  
127 Bbls oil

COMPLETED

Map No. 26 Sec. 11 Twp. 17 R. 4E

Well No. 3. Cowman

Harwood et al Company

Contractor

**FIRST REPORT**

**SECTION PLAT**

\_\_\_\_\_ Ft. from N. Line

1070 Ft. from S. Line

1070 Ft. from E. Line

\_\_\_\_\_ Ft. from W. Line

	o		

Location \_\_\_\_\_

Rig up \_\_\_\_\_

Drilling and Remarks:

*Rig*

**RECORD**

Cased \_\_\_\_\_ in., \_\_\_\_\_ ft.

Sand \_\_\_\_\_

Gas \_\_\_\_\_

Oil \_\_\_\_\_

Total Depth \_\_\_\_\_

**PRODUCTION**

1st 24 hrs. Nat. \_\_\_\_\_

1st 24 hrs. after shot \_\_\_\_\_

Gas \_\_\_\_\_ Cu. Ft.

Dry Hole \_\_\_\_\_

Abandoned \_\_\_\_\_

Date

6-13-37 19

**ORVAL MANSCHRECK**

Scout

KANSAS

Map No. 26 Sec. 11 Twp. 17 R. 4E

Well No. 3-Cowman

Harwood et al Company

Contractor

**COMPLETED**

SECTION PLAT

	0		

\_\_\_\_\_ Ft. from N. Line

1070 Ft. from S. Line

1070 Ft. from E. Line

\_\_\_\_\_ Ft. from W. Line

Location \_\_\_\_\_

Rig up \_\_\_\_\_

Drilling and Remarks:

127 bbls  
oil



RECORD

Cased \_\_\_\_\_ in., \_\_\_\_\_ ft.

Sand Chat 234.3

Gas \_\_\_\_\_

Oil \_\_\_\_\_

Total Depth 2378

PRODUCTION

1st 24 hrs. Nat. \_\_\_\_\_

1st 24 hrs. after shot \_\_\_\_\_

Gas \_\_\_\_\_ Cu. Ft.

Dry Hole \_\_\_\_\_

Abandoned \_\_\_\_\_

Date

8-22-31

ORVAL MANNSCHRECK

Scout