


Section 11 2 Township 17 Range 4 EWell No. # 2 Martin #1 DaetwilerCompany Clark, Miller, & Ray Anthony
Irvin Daetwiler et al

NORTH

WEST

EAST

SOUTH

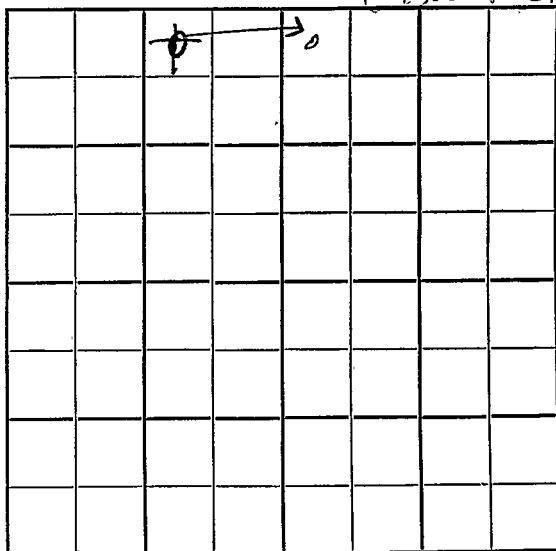

Marion

KANSAS ✓

Sec. 2 11 Twp. 17 R. 4 EWell No. #1 Daetwiler
#2 Martin Farm
Clark, Milico & Ray Anthony
Irvin Daetwiler et al Company

Slußer Drlg.

Contractor

Lost Springs Pool

330

Ft. from N. Line

Ft. from S. Line


~~990~~

Ft. from E. Line

330

Ft. from W. Line

NORTH

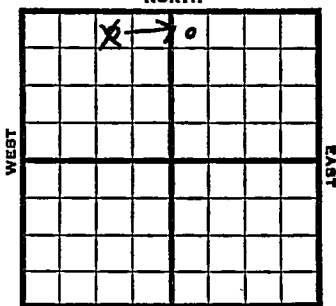

SOUTH

~~NW NE NW~~

NW NW NE

1953

Elev. -

REPORT

6/17

Location

7/29

Spud 7-1-53

Oil well TD 2346 8" @ 92

KC 1710 Miss 2310 TD 2311

4" @ 2311 DD 2346 FU 1100' oil

S/1 BOPH Hydro.

Comp. 20 BOPD 5 BW

COMPLETED

County Marion State Kansas
 Sec. 2 (Blk. 17 (Sur. 4E Map No.
 (Twp.) (Rge.)
 Operator Irvin Daetwiler etal.
 Well No. 2 Farm Martin
 Elev. Location NW NE NW

		o					

330 Ft. From N Line NW
 990 Ft. From: E Line Quarter
 Ist. Report JUN 17 1953

Completion

Remarks

Slusser Drlg. - Contr.

Spudding Date

Drlg. Data

Lost Springs Pool

Location

J. G. McGEHEE

Scout Cards	mm
Land Small Map	
Land Wall Map	BR
Tracings	
France Map	
Pierce Map	
Misc.	

JUN 18 1953

Orig. Data

Kansas

Map No. _____ Sec. 11 Twp. 17 R. 4EWell No. 1 DaetwilerClark, Miller & Ray Anthony CompanyCORRECTION Contractor

NW NW NE

SECTION PLAT

330 Ft. from N. Line

_____ Ft. from S. Line

_____ Ft. from E. Line

330 Ft. from W. Line

		o	
			s

Marion County

Location _____

Rig up _____

Drilling and Remarks:

Reported
Irvin Daetwiler
#2 Martin
2-17-4E

RECORD

Cased _____ in., _____ ft.

Sand _____

Gas _____

Oil _____

Total Depth _____

etal • PRODUCTION

1st 24 hrs. Nat. _____

1st 24 hrs. after shot _____

Gas _____ Cu. Ft.

Dry Hole _____

Abandoned _____

Date

JUL 1 1953

19

J. G. McGEHEE

Scout





JUL

6 1903

Scout Cards	<i>mm</i>
Land Small Map	
Land Wall Map	<i>GR</i>
Tracings	
France Map	
Pierce Map	
Misc.	

J. G. McGEHEE

Scout Cards

Land Small Map

Land Wall Map

Tracings

France Map

Pierce Map

Misc

AUG

4

1953

Drig. Date