

Section 11 Township 17 Range 4 EWell No. # 1 NiceCompany Geo. Geisler et al

NORTH							
		0					
SOUTH							

WEST EAST

Marion KANSAS ✓

Sec. 11 Twp. 17 R. 4EWell No. #1 Nice FarmGeo. Geisler et al CompanySlusser Drlg. ContractorLost Springs Pool330

Ft. from N. Line


Ft. from S. Line

990

Ft. from E. Line

Ft. from W. Line

NW NE NW

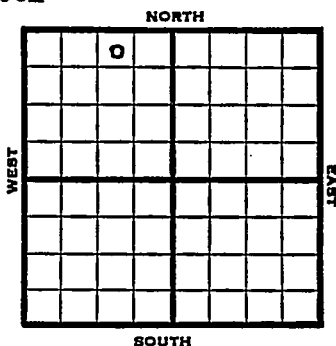

1953

Elev. 1457' REPORT

5/13

Spud 5-3-53

8" @ 102

Miss Chat 2327

TD 2330

4½" @ 2329, WOC

6/17

Spud 5-3-53

Oil Well

TD 2330'

8" @ 102'

Miss 2327,

TD 2330'

4½" @ 2329'

CO to 2330 sd-oil-frac.

Comp. 9 bopd 17 bw.

COMPLETED

County Marion State Kansas
 Sec. 11 (Blk.) 17 (Sur.) 4E Map No.
 Operator Geo. Geisler et al.
 Well No. 1 Farm Nice
 Elev. Location NW NE NW

		0					

330 Ft. From N Line NW
 990 Ft. From E Line Quarter
 1st. Report MAY 13 1953
 Completion
 Remarks
Slusser Drlg. - Contr.
 Spudding Date 5-3-53

Drlg. Data Lost Springs Pool
8" @ 102 Miss. chat 2327 TD 2330
4 $\frac{1}{2}$ " @ 2329 WOC

County Marion State Kansas
 Sec. 11 (Blk.) 17 (Sur.) 4E Map No.
 Operator Geo. Geisler etal.
 Well No. 1 Farm Nice
 Elev. 1457 Location NW NE NW

330 Ft. From N Line NW990 Ft. From E Line Quarter

1st. Report

Completion JUN 17 1953Remarks Lost Springs PoolSlusser Drlg. - Contr.Spudding Date 5-3-53

Drlg. Data Oil well TD 2330
8" @ 102 Miss. 2327 TD 2330 4 $\frac{1}{2}$ " @
2329 CO to 2330 sd-oil-frac
Comp. 9 bopd 17 bw

J. G. MCGEHEE