


Franklin

Form 51-5M-11-38-Palace

Section 11 Township 17 Range 17-E

Well No. #1 Tealls

Company Security Oil & Gas

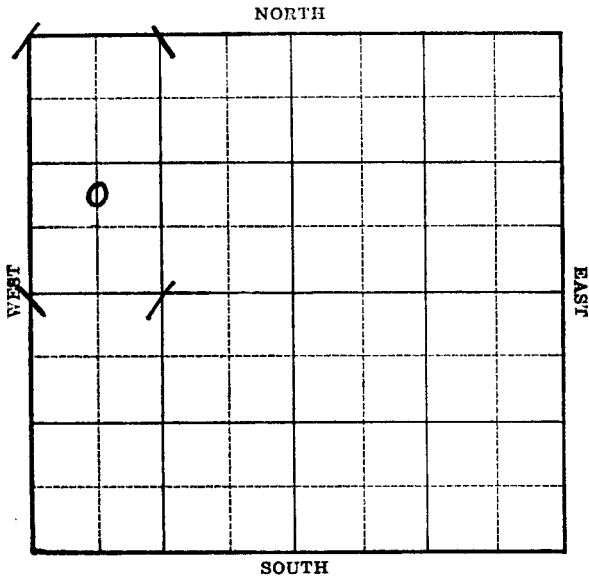

Sec. 11 Twp. 17 R. 17-E

Well No. #1 Tealls Farm

Security Oil & Gas Company


(Miscellaneous)

 Ft. from N. Line

990 Ft. from S. Line

660 Ft. from E. Line

 Ft. from W. Line

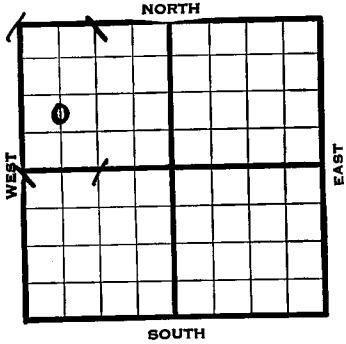

| 1939 | REPORT |
|-------|--------------------------------|
| 7/26 | 12" - 56' |
| | Spud 153' |
| 8/3 | Spud 153' & SD. |
| 8/10 | 10" - 400' T.D. 450' U.P. 10". |
| 8/17 | 10" - 450' Drlg. 460' |
| 8/24 | Shut down. |
| 8/31 | " " |
| 9/7 | Drlg. 520' |
| 9/14 | Fishing 815' |
| 9/21 | Drlg. 935' |
| 9/28 | T.D. 1050' Run 8". |
| 10/5 | " " " " |
| 10/12 | Shut down. |
| 10/19 | " " |
| 10/26 | " " |
| 11/2 | 8" - 1045' Drlg. 1100' |
| 11/9 | Drlg. 1200' Caving. |
| | |
| | |
| | |
| | |

.939

.1/15. Bart. 1203' water.

T.D. 1205'

Map No. NY Sec. 11 Twp. 17 R. 17EWell No. 1 Tealls**Security Oil & Gas**

Company


Contractor

FIRST REPORT**C N L SW NW**

_____ Ft. from N. Line

990 Ft. from S. Line660 Ft. from E. Line

_____ Ft. from W. Line

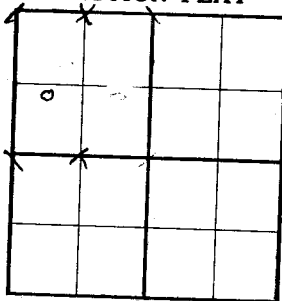MISCELLANEOUS**SECTION PLAT**

Location _____

Rig up _____

Drilling and Remarks:

12" - 56Spud 153**RECORD**

Cased _____ in., _____ ft.

Sand _____

Gas _____

Oil _____

Total Depth _____

PRODUCTION

1st 24 hrs. Nat. _____

1st 24 hrs. after shot _____

Gas _____ Cu. Ft.

Dry Hole _____

Abandoned _____

Date

JUL 26 1939

19

S. J. LEWIS

Scout

Franklin

1933

Map No. No Map Sec. 11 Twp. 17 R. 17E

Well No. 1 Tealls

Security Oil & Gas Company

Contractor

ABANDONED
C N L SW NW

SECTION PLAT

| | | | |
|---|--|--|--|
| | | | |
| o | | | |
| | | | |
| | | | |

_____ Ft. from N. Line
990 Ft. from S. Line
660 Ft. from E. Line
 _____ Ft. from W. Line

MISCELLANEOUS

Location _____

Rig up _____

Drilling and Remarks:

Bar 1202.
Water.

RECORD

Cased _____ in., _____ ft.

Sand _____

Gas _____

Oil _____

Total Depth 1205

PRODUCTION

1st 24 hrs. Nat. _____

1st 24 hrs. after shot _____

Gas _____ Cu. Ft.

Dry Hole _____

Abandoned _____

Date

NOV 15 1939 19

S. J. LEWIS Scout