


Map No. Kansas Sec. 11 Twp. 17 R. 12Well No. 1- Chatterton FarmDouble A' Oil Company

NORTH

WEST

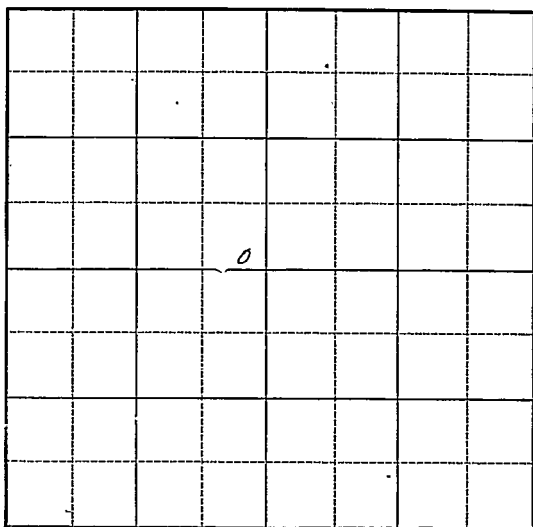

EAST

SOUTH

Location _____

Drilling Remarks _____

Rig Up _____

Drilling Remarks _____

RECORD

Cased _____ in. _____ ft.

Sand _____

Gas _____

Oil _____

Total Depth _____

PRODUCTION

1st 24 hrs. Nat. _____

1st 24 hrs. after shot _____

Gas _____ cu. ft.

Dry Hole _____

Abandoned _____

Lyon Co

Map No. 11 Sec. 11 Twp. 17 R. 12

Well No. 1 Chatterton Farm

Double O. & L. Company


NORTH

-----Ft. from N. Line

330 Ft. from S. Line

330 Ft. from E. Line

Ft. from W. Line

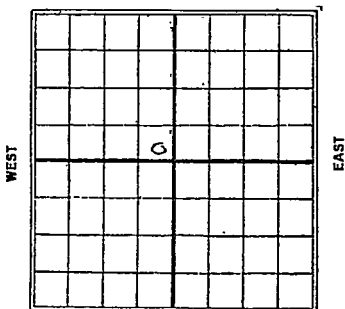

SOUTH

Date / REPORT

1928	
3/31	Location

4/7/ —

4/15 Spudding

4/21	Running 12" 400
------	-----------------

4/28	Slg 900'
------	----------

5/8	"	1135.
-----	---	-------

5/14	"	1700'
------	---	-------

5/12	Broken Sand. 1910-15
------	----------------------

Burgess 2030-50

Top line 2050'

first break. 2118' D7A

2118 J.D.

normal
 Map No. **KANSAS** Sec. *11* Twp. *17* R. *12*
Double # one 300 Company

Contractor

FIRST REPORTS

SECTION PLAT

Ft. from N. Line

Ft. from S. Line

Ft. from E. Line

Ft. from W. Line

Location *✓*

Rig up

Drilling and Remarks:

RECORD

Cased _____ in., _____ ft.

Sand _____

Gas _____

Oil _____

Total Depth _____

PRODUCTION

1st 24 hrs. Nat. _____

1st 24 hrs. after shot. _____

Gas _____ Cu. Ft.

Dry Hole _____

Abandoned _____

Date

MAR 31 1926

CHAS. L. SHERWOOD

Scout

no map
 Map No. KANSAS Sec. 11 Twp. 17 R. 12
 Well No. 1 Chatterton
Double H Oil Co Company

Contractor

COMPLETED

SECTION PLAT

Ft. from N. Line

330

Ft. from S. Line

330

Ft. from E. Line

Ft. from W. Line

ABANDONED

Location

Rig up

Drilling and Remarks:

Do 2d 1910-15
Burgess 2030-50
Tap line 2050
1st Break 2118
129 2118

RECORD

Cased _____ in., _____ ft.

Sand _____

Gas _____

Oil _____

Total Depth 2118

PRODUCTION

1st 24 hrs. Nat. _____

1st 24 hrs. after shot. _____

Gas _____ Cu. Ft.

Dry Hole ☒Abandoned ☒

Date

MAY 19 1926

CHAS. L. SHERWOOD

192

Scout