


Marion

KANSAS

SECTION 13 TOWNSHIP 17 RANGE 4 E

WELL NO. #2 McCoy

COMPANY Irvin Daetwiler

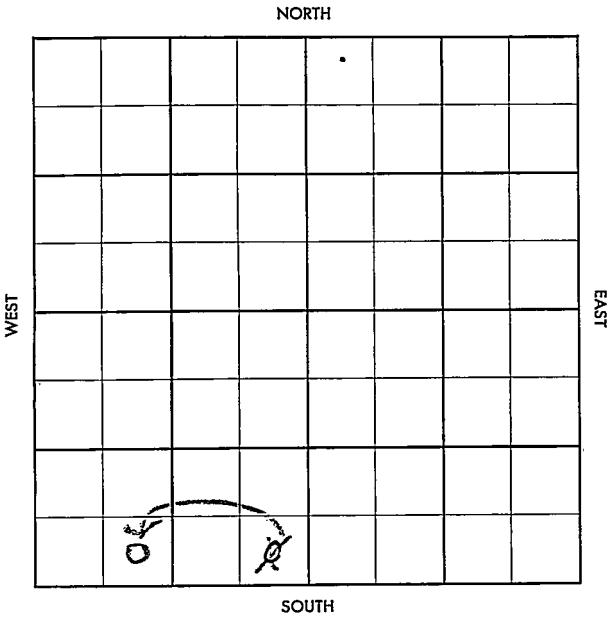

Marion

KANSAS

SEC. 13.	TWP. 17	R. 4E
-------------	------------	----------

WELL NO.

#2 McCoy

FARM

COMPANY

Irvin Daetwiler

CONTRACTOR

Slusser

Lost Springs


Ft. from N. Line

Ft. from S. Line

Ft. from E. Line

Ft. from W. Line

SE SE SW

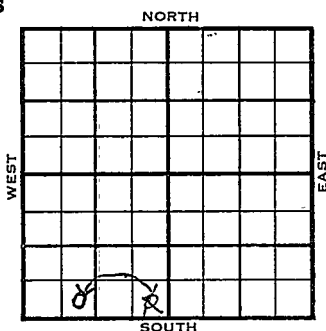

	ELEVATION	REPORT
--	-----------	--------

1956

1-25

Comm. 1-20-56

8" @ 90

Drlg. 1895'

County Marion

Elev.

Sec. 13

Twp.

17

Rge.

4ECompany Irwin Daetwiler

Farm Name

McCoy

No.

2

TOPS

DEPTH

LOG

DATUM

Loc. in Sec.

Anh.

SE SE SW

Tp.

H.

Tr.

Dg.

Bl.

L.

K.C.

B.K.C.

Ce.

C.

M.

M.

K.

Mz.

Mq.

V.

S.

S.

A.

R.

Pe.

G.

T.D.

Geol.

Contr.

Slusser

Pool

Lost Springs

FIRST REPORT

JAN 25 '56

0

Date Comm.

1-20-568" @ 90drlg. 1895

Co.

Lse.

No.

Sec.

T.

R.

County Marion Elev. 1471
 Sec. 13 Twp. 17 Rge. 4E
 Company Irvin Dastwiler
 Farm Name McCoy No. 2

TOPS	DEPTH	LOG	DATUM	Loc. in Sec.
Ant.				SE SE SW
Tp.				SW
H.				1230 WL
Tc.				
Dg.				
Bl.				
L.				
M.C.				Geol.
BXC.				Contr.
Ce.				Slusser
C.				Pool
M. <u>chat</u>	<u>2320</u>		<u>849</u>	Lost Springs
M.				
K.				
Mz.				
Ma.				
V.				
S.				
S.				
A.				
R.				
FE.				
G.				
TD.	<u>2322</u>			

Date Comm. 1-20-56 FEB 15 1956

8" @ 90 drlg. 1895 FEB 1 '56 5 1/2 2322

125 MICT FEB 9 '58 ca DD 2357 TP

75t 550 + wth FU 300' Fluid
(125' wtr) 16 hrs Frac. & 4d.

FEB 15 '58 P. 40. B0 + 50 to wth