

Marion


KANSAS

SECTION 14 TOWNSHIP 17S RANGE 4E

WELL NO. #1 Knight

COMPANY Irvin Daetwiler

NORTH *SE NE*  
*NE SE SE*

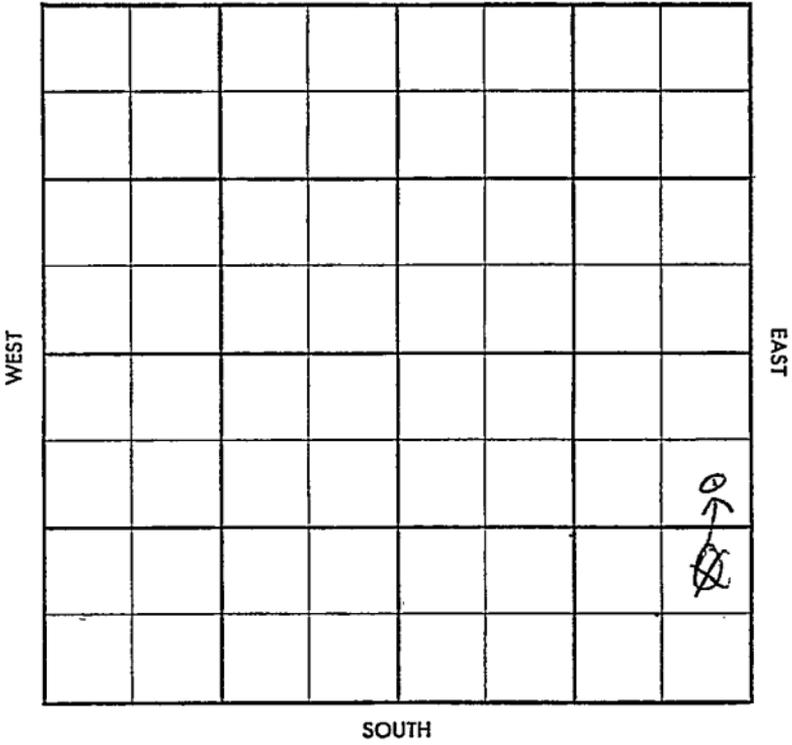

~~Production Pool~~  
~~FACT-10~~

S-513-B

County Marion Elev. \_\_\_\_\_  
 Sec. 14 Twp. 17 Rge. 4E  
 Company Irvin Daetwiler  
 Farm Name Knight No. 1

TOPS	DEPTH	LOG	DATUM
Anh.			
Tp.			
H.			
Tr.			
Dg.			
B.L.			
L.			
K.C.			
B.K.C.			
Ce.			
C.			
M.			
M.			
K.			
Mz.			
Mq.			
V.			
S.			
S.			
A.			
R.			
Pf.			
G.			
T.D.			

Loc. in Sec. NE SE SE  
 Geol. \_\_\_\_\_  
 Contr. Slusser  
 Pool Lost Springs

MAY 21 1958  
**FIRST REPORT**

Date Comm. 5-16-58  
8" @ 215/125 drlg. 2080

Co.  
 Lse.  
 No.  
 Sec.  
 T.  
 R.

# CORRECTION

Twp. C Pool X  
 Co. X Facet X

S-513-B

County Marion Elev. 14610 or 14648  
 Sec. 14 Twp. 17 Rge. 1E  
 Company Irvin Daetwiler  
 Farm Name Knight No. 1

TOPS	DEPTH	LOG	DATUM
Anh.			
Tr.			
Dg.			
B.L.			
L.			
K.C.			
B.K.C.			
Ce.			
C.			
M.	<u>Chat 2315</u>		
M.			
K.			
Mz.			
Mq.			
V.			
S.			
A.			
R.			
Pf.			
G.			
T.D.	<u>2316</u>		

Loc. in Sec. NE SE SE  
SE NE SE

Geol. \_\_\_\_\_  
 Contr. Slusser  
 Pool \_\_\_\_\_  
Lost Springs

COMPLETE  
 JUN 1 1958

Date Comm. 5-16-58  
8" @ .215/125 drlg. 2080 MAY 26 '58 : 4"

2315 wolt COOP 2350 TD  
\$ 2 1/2 BO per NW frac  
JUN 1 '58 \$1480 in 7 minutes \$1480 in 15"  
NW \$ 25 BO per NW + W

