

marion

Map No. _____ Sec. 14 Twp. 17 R. 4^E

Well No. 1-Riffel Farm
Youker-Phillips Company


NORTH

220 Ft. from N. Line

_____ Ft. from S. Line

_____ Ft. from E. Line

220 Ft. from W. Line

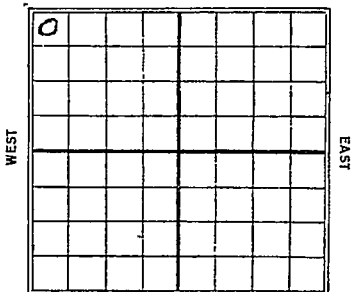

SOUTH

Date

REPORT

1930

8/27

8" 1675

9/3

Setg. 6" - 2195'

9/10

Chat 2328-76

5" - 2328

TD 2376

PB. to 2372'

75 bbl oil

Comp.

Marion

26 **KANSAS** Map No. _____ Sec. *14* Twp. *17* R. *4* ^E
 Well No. *1* *Rizzel*
Yunker & Phillips Company Contractor

FIRST REPORTS

220 Ft. from N. Line
 _____ Ft. from S. Line
 _____ Ft. from E. Line
220 Ft. from W. Line

SECTION PLAT

<i>0</i>			

Location _____

Rig up _____

Drilling and Remarks:

8" 1675

RECORD

Cased _____ in. _____ ft.

Sand _____

Gas _____

Oil _____

Total Depth _____

PRODUCTION

1st 24 hrs. Nat. _____

1st 24 hrs. after shot _____

Gas _____ Cu. Ft.

Dry Hole _____

Abandoned _____

Date

AUG 27 1930

CHAS. L. SHERWOOD

19

Scout

Marion

Map No. **KANSAS** Sec. 14 Twp. 17 R. 4

Well No. 26 1 Riegel

Yunker & Phillips Company

Contractor

COMPLETE

SECTION PLAT

0			

220 Ft. from N. Line

..... Ft. from S. Line

..... Ft. from E. Line

220 Ft. from W. Line

Location.....

Rig up.....

Drilling and Remarks:

5" 2328

AB to 2372

75 Bls.

RECORD

Cased..... in., ft.

Sand. Chat 2328-2376

Gas.....

Oil.....

Total Depth 2376

PRODUCTION

1st 24 hrs. Nat.....

1st 24 hrs. after shot.....

Gas..... Cu. Ft.

Dry Hole.....

Abandoned.....

Date

SEP 10 1930

CHAS. L. SHERWOOD

192

Scout