


Morris
 Map No. **KANSAS** Sec. *14* Twp. *17* R. *7* ✓
 Well No. *1* *unknown* Farm.
Lewis & Anderson Company

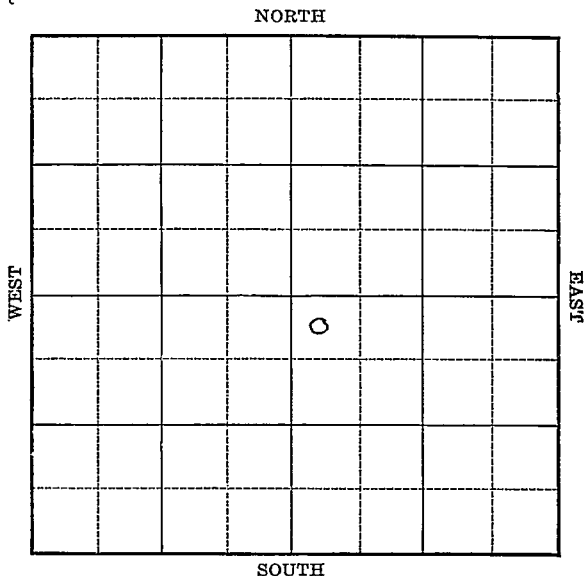

Location _____

Drilling Remarks _____

Rig Up _____

Drilling Remarks _____

RECORD


Cased _____ in. _____ ft.
 Sand _____
 Gas _____
 Oil _____
 Total Depth _____

PRODUCTION

1st 24 hrs. Nat. _____
 1st 24 hrs. after shot _____
 Gas _____ cu. ft.
 Dry Hole _____
 Abandoned _____

Well No. 1 - unknown Farm
Lewis & Anderson Company

250 Ft. from W. Line

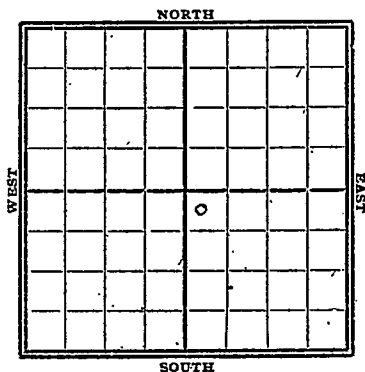

1928

REPORT

10/17	dry 1570'
10/24	S.D. 1730'
10/31	_____
11/7	_____
11/14	_____
11/21	_____
11/28	_____
12/5	_____
12/12	T.D. 1735'
	Dry & Abandoned

Morris

K27 KANSAS

MAP NO. _____ SEC. 14 TWP. 17 R. 7

WELL NO. 1

Unknown

Lewis & Anderson

COMPANY

CONTRACTOR

SECTION PLAT

FIRST REPORTS

250

Ft. FROM N. LINE

Ft. FROM S. LINE

Ft. FROM E. LINE

250

Ft. FROM W. LINE

		0	

LOCATION _____

RIG UP _____

DRILLING AND REMARKS:

Dlg 1570'

RECORD

CASED _____ IN. _____ FT.

SAND _____

GAS _____

OIL _____

TOTAL DEPTH _____

PRODUCTION

1ST 24 HRS. NAT. _____

1ST 24 HRS. AFTER SHOT _____

GAS _____ Cu. Ft.

DRY HOLE _____

ABANDONED _____

DATE

OCT 17 1928

CHAS. L. SHERWOOD

192

SCOUT

Morris

K27

KANSAS

Map No.

Sec:

14

Twp.

17

R.

7

Well No.

1 Unknown

Lewis & Anderson

Company

Contractor

COMPLETED SECTION PLAT

750

Ft. from N. Line

Ft. from S. Line

Ft. from E. Line

750

Ft. from W. Line

ABANDONED

		0	

Location

Rig up

Drilling and Remarks:

RECORD

Cased in., ft.

Sand

Gas

Oil

Total Depth 1735

PRODUCTION

1st 24 hrs. Nat.

1st 24 hrs. after shot

Gas Cu. Ft.

Dry Hole

Abandoned

Date

DEC 12 1928

CHAS. L. SHERWOOD

192

Scout