


Marion
Form 51-5M-2-29-34703

Map No. KANSAS Sec. 15 Twp. 17 R. 4^E

Well No. 1- Mc Nicol Farm
Stearns & Streeter Company

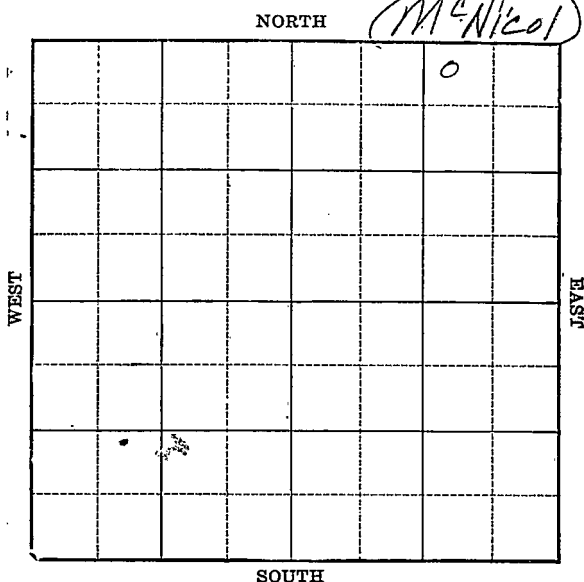

Location _____

Drilling Remarks _____

Rig Up _____

Drilling Remarks _____

RECORD

Cased _____ in. _____ ft.

Sand _____

Gas _____

Oil _____

Total Depth _____

PRODUCTION

1st 24 hrs. Nat. _____

1st 24 hrs. after shot _____

Gas _____ cu. ft.

Dry Hole _____

Abandoned _____

Map No. KANSAS Sec. 15 Twp. 17 R. 4th
 Well No. 1-M^e Nicie Farm
Stearns & Strutt Company


250 Ft. from N. Line

_____ Ft. from S. Line

1120 Ft. from E. Line

_____ Ft. from W. Line

1930

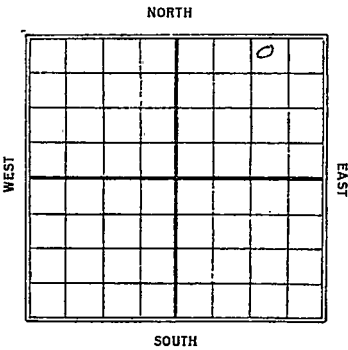

Date	REPORT
7/2	Bldg. rig
7/9	Rig
7/16	—
7/23	—
7/30	—
8/6	—
8/13	—
8/20	Spdy 100'
8/27	hrlg. 600'
9/3	Frg. 12"- 996'
9/9	—
9/16	Dry 1895'
9/24	Oil 2295'
10/1	Chat 2345-91
	swab 4 bbl per hr
10/8	Sand 2345-92
	TD 2392
	112 bbls oil
	Comp.

Marion

Map No. KANSAS Sec. 15 Twp. 17 R. 4^EWell No. 26 1

McNical

Stearns & Streeter

Company

Contractor

FIRST REPORTS

SECTION PLAT

250 Ft. from N. Line

_____ Ft. from S. Line

1120 Ft. from E. Line

_____ Ft. from W. Line

			0

Location _____

Rig up _____

Drilling and Remarks: _____

Bldg. Rig

RECORD

Cased _____ in., _____ ft.

Sand _____

Gas _____

Oil _____

Total Depth _____

PRODUCTION

1st 24 hrs. Nat. _____

1st 24 hrs. after shot _____

Gas _____ Cu. Ft.

Dry Hole _____

Abandoned _____

Date

JUL 2 1930

19

CHAS. L. SHERWOOD

Scout

Marion

Map No. _____ Sec. 15 Twp. 17 R. 4
26
 Well No. 1 Mc Neal
Stearns & Streeter Company

Contractor

COMPLETE

SECTION PLAT

750 Ft. from N. Line

_____ Ft. from S. Line

1120 Ft. from E. Line

_____ Ft. from W. Line

			0

Location _____

Rig up _____

Drilling and Remarks: _____

112 hrs.

RECORD

Cased _____ in., _____ ft.

Sand 2345-2392

Gas _____

Oil _____

Total Depth 2392

PRODUCTION

1st 24 hrs. Nat. _____

1st 24 hrs. after shot _____

Gas _____ Cu. Ft. _____

Dry Hole _____

Abandoned _____

Date

OCT 8

1930

CHAS. L. SHERWOOD

192

Scout