


Map. No. **KANSAS** Sec. 15 Twp. 17 R. 4
 Well No. 2 - Frank Farm
Phillips Pet Company

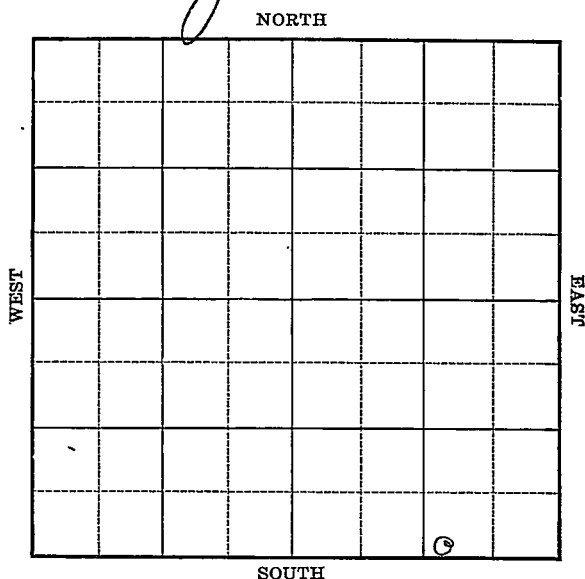

Location _____

Drilling Remarks _____

Rig Up _____

Drilling Remarks _____

RECORD

Cased _____ in. _____ ft.

Sand _____

Gas _____

Oil _____

Total Depth _____

PRODUCTION

1st 24 hrs. Nat. _____

1st 24 hrs. after shot _____

Gas _____ cu. ft.

Dry Hole _____

Abandoned _____

Marion

KANSAS
 Map No. *No. 2* Sec. *15* Twp. *17* R. *4* ^E
 Well No. *2* *Frank*
Phillips *Pet* *Co* Company
 Contractor

FIRST REPORTS

_____ Ft. from N. Line
150 Ft. from S. Line
1075 Ft. from E. Line
 _____ Ft. from W. Line

SECTION PLAT

			0

Location _____
 Rig up *Rign up*
 Drilling and Remarks:

RECORD

Cased _____ in., _____ ft.
 Sand _____
 Gas _____
 Oil _____
 Total Depth _____

PRODUCTION

1st 24 hrs. Nat. _____
 1st 24 hrs. after shot _____
 Gas _____ Cu. Ft.
 Dry Hole _____
 Abandoned _____

Date

MAY 3 1928 CHAS. L. SHERWOOD
 192 Scout

