


KANSAS

Map No. \_\_\_\_\_ Sec. 15 Twp. 17 R. 4

Well No. 2 - McNicholls Farm

Tom C. Johnson Company  
NORTH (McNicol) 7

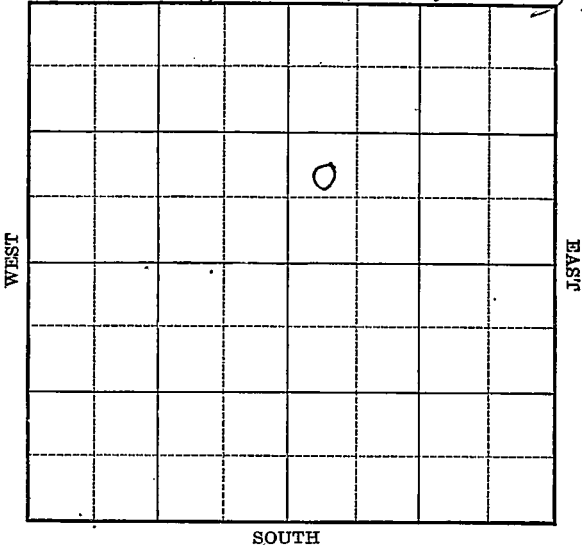

Location \_\_\_\_\_

Drilling Remarks \_\_\_\_\_

\_\_\_\_\_

\_\_\_\_\_

Rig Up \_\_\_\_\_

Drilling Remarks \_\_\_\_\_

\_\_\_\_\_

\_\_\_\_\_

RECORD

Cased \_\_\_\_\_ in. \_\_\_\_\_ ft.

Sand \_\_\_\_\_

Gas \_\_\_\_\_

Oil \_\_\_\_\_

Total Depth \_\_\_\_\_

PRODUCTION

1st 24 hrs. Nat. \_\_\_\_\_

1st 24 hrs. after shot \_\_\_\_\_

Gas \_\_\_\_\_ cu. ft.

Dry Hole \_\_\_\_\_

Abandoned \_\_\_\_\_

Map No. **KANSAS** Sec. 15 Twp. 17 R. 4


Well No. 2-McNicholls Farm  
Tom C. Johnson Company

\_\_\_\_\_ Ft. from N. Line

990 Ft. from S. Line

\_\_\_\_\_ Ft. from E. Line

330 Ft. from W. Line

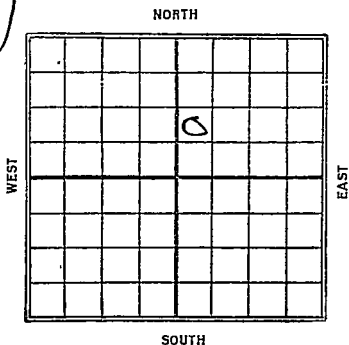

1928

Date	REPORT
5/17	R.O.G.
5/24	Dry
5/31	dry 300'
6/7	" 1450
6/14	fishing 1450
6/21	Dry 1767-
6/28	" 2125
7/6	Chat 2345 - oil 2365
7/13	T.W. 2385 - 900' oil in hole.
7/13	2345 - 2385 T.D. 2385 Oil 2365' 50 bbls

*Marion*

MAP NO. 210 Irving **KANSAS** SEC. 15 TWP. 17 R. 4

WELL NO. 2 *Mc Nicholls*  
Tom. C. Johnson COMPANY

CONTRACTOR

**FIRST REPORTS**

**SECTION PLAT**

\_\_\_\_\_ FT. FROM N. LINE  
990 FT. FROM S. LINE  
 \_\_\_\_\_ FT. FROM E. LINE  
330 FT. FROM W. LINE

		o	

LOCATION Bog  
 RIG UP \_\_\_\_\_  
 DRILLING AND REMARKS:

**RECORD**

CASED \_\_\_\_\_ IN. \_\_\_\_\_ FT.  
 SAND \_\_\_\_\_  
 GAS \_\_\_\_\_  
 OIL \_\_\_\_\_  
 TOTAL DEPTH \_\_\_\_\_

**PRODUCTION**

1ST 24 HRS. NAT. \_\_\_\_\_  
 1ST 24 HRS. AFTER SHOT \_\_\_\_\_  
 GAS \_\_\_\_\_ CU. FT.  
 DRY HOLE \_\_\_\_\_  
 ABANDONED \_\_\_\_\_

DATE MAY 17 1928

**CHAS. L. SHERWOOD**  
 SCOUT

*Marion*

MAP NO. *15* SEC. *15* TWP. *17* R. *4*

WELL NO. *2* *Mc Nicholls*

*Tom C Johnson* COMPANY

CONTRACTOR

SECTION PLAT

COMPLETED

\_\_\_\_\_ FT. FROM N. LINE

*990* FT. FROM S. LINE

\_\_\_\_\_ FT. FROM E. LINE

*330* FT. FROM W. LINE

		0	

LOCATION \_\_\_\_\_

RIG UP \_\_\_\_\_

DRILLING AND REMARKS:

*oil 2365'*

*50. 2365'*

RECORD

CASED \_\_\_\_\_ IN. \_\_\_\_\_ FT.

SAND *2345-2385*

GAS \_\_\_\_\_

OIL \_\_\_\_\_

TOTAL DEPTH *2385*

PRODUCTION

1ST 24 HRS. NAT. \_\_\_\_\_

1ST 24 HRS. AFTER SHOT \_\_\_\_\_

GAS \_\_\_\_\_ CU. FT.

DRY HOLE \_\_\_\_\_

ABANDONED \_\_\_\_\_

DATE \_\_\_\_\_

*7/13/28* 192

*Aherwood*

SCOUT