

NO-RECORD

Marion  
O.W.W.O.

KANSAS

SECTION 15 TOWNSHIP 17 RANGE 4E

WELL NO. #2 Svoboda

COMPANY Slusser Drlg. Co.

NORTH

14

WEST

EAST


SOUTH

0

Marion

KANSAS

SEC. 15	TWP. - - 17	R. 1E
------------	----------------	----------

WELL NO. #1 Svoboda FARM

COMPANY Slusser Drlg. Co. (SWD)

CONTRACTOR Co.

Lost Springs


\_\_\_\_\_ FT. FROM N. LINE

120 \_\_\_\_\_ FT. FROM S. LINE

280 \_\_\_\_\_ FT. FROM E. LINE

\_\_\_\_\_ FT. FROM W. LINE

of SW/4  
SW SE SW

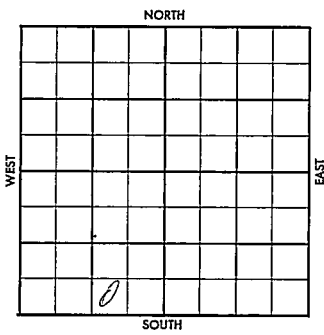

1956	ELEVATION	REPORT
------	-----------	--------

8-29	Comm, 8-20-56 8" @ 128 w/65; RTD 2713'; 5" @ 2640 TD in Hunton; CO 2635; 2635 TD for disposal well Nat. M. 2385'; Hunton 2635'; TD 2713' SWD
------	---

**FIRST REPORT**

**ABANDONED**

County Marion Elev. \_\_\_\_\_  
 Sec. 15 Twp. 17S Rge. 4E  
 Company Slosser Drlg. Co.  
 FarmName Svoboda No. 1

TOPS	DEPTH	LOG	DATUM	Loc. in Sec.
Anh.				SWD
TP.				SW SE SW
H.				280' FEL X
Tr.				120' FSL of
Dg.				SW/4
Bl.				
L.				Geol. _____
K.C.				Contr. _____
B.K.C.				
Ce.				Co. _____
C.				
M.	2385			Pool
M. <u>Hunton</u>	2635			Lost Springs
K.				
Mz.				
Mo.				
V.				
S.				
S.				FIRST REPORT
A.				
R.				
PE.				COMPLETE
G.				ABANDONED
TD.	<u>2713</u>			

Date Comm. 8-20-56  
8" 128 w/65; RTD 2713; 5" 2640; TD in  
Hunton; CO 2635; 2635 TD for disposal  
well Nat. SWP

220

**NO-RECORD  
O.W.W.O.**

FORM 513 SUNRAY

County Marion Elev. \_\_\_\_\_  
 Sec. 15 Twp. 17S Rge. 4E  
 Company Shusser Drig. Co.  
 Farm Name Svoboda No. 2

TOPS	DEPTH	LOG	DATUM	Loc. in Sec.
Anh.				SW SE SW
Tr.				<del>DS SW/4</del>
Dg.				
Bl.				
L.				Geol. _____
K.C.				Contr. _____
B.K.C.				Co. _____
Ce.				
C.				Pool _____
M.				
M.				Lost Springs _____
K.				
Mz.				
Me.				
V.				
S.				
S.				
A.				
R.				
PE.				
G.				
T.D.				

**FIRST REPORT**  
 AUG 29 '56  
 0

Date Comm. \_\_\_\_\_

Old operator was Auguste, farm was Skelnar

MIRT

*[Handwritten signature]*

Co.  
Lse.  
No.  
Sec.  
T.  
R.