


Map No. **KANSAS** Sec. 15 Twp. 17 R. 4
Well No. 1 - Town Lot Farm
Harwood & Winters Company

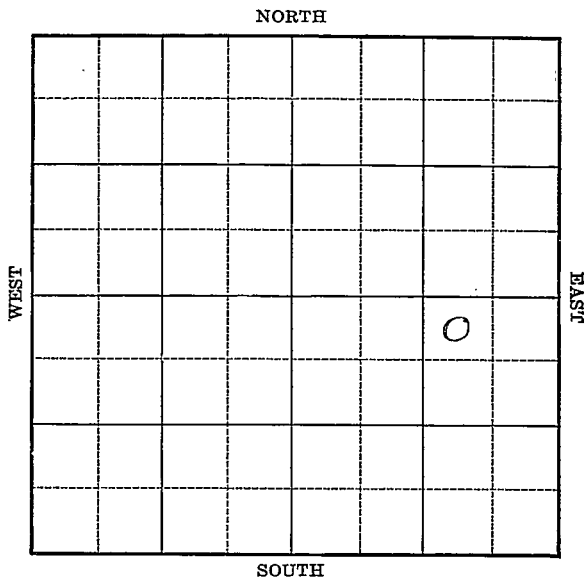

Location _____

Drilling Remarks _____

Rig Up _____

Drilling Remarks _____

RECORD

Cased _____ in. _____ ft.

Sand _____

Gas _____

Oil _____

Total Depth _____

PRODUCTION

1st 24 hrs. Nat. _____

1st 24 hrs. after shot _____

Gas _____ cu. ft.

Dry Hole _____

Abandoned _____

Map No. 1 Kansas Sec. 15 Twp. 17 R. 4

Well No. 1 - Town lot. Farm

Harwood & Winters Company


NORTH

330 Ft. from N. Line

_____ Ft. from S. Line

990 Ft. from E. Line

_____ Ft. from W. Line

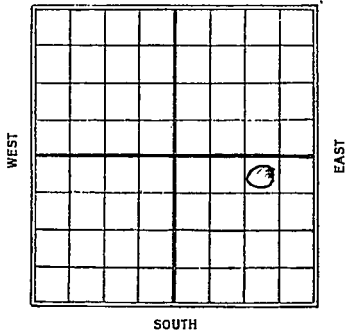

1927

Date	REPORT
9/38	Rig up
10/6	Rigging up
10/12	Spudding
10/19	Drlg 950
10/27	" 1365
11/2	" 2025'
11/9	" 2355
11/16	Top chat 2385 - water 2402-2414
	500' water + show oil - set 5" - 2417-
	Ady line + oil 2435-39-
	1450' oil in hole-
11/23	f g. c g.
11/30	~~~~~
12/7	~~~~~
12/14	~~~~~
12/21	~~~~~
12/29	~~~~~
1928	~~~~~
1/5	~~~~~
1/11	~~~~~
	(over)

1/18/28 - Top chat 2385
water 2402-14
5" 2417
chat + Pay 2435-39
1450 ft oil hole
abandoned 2439'

Marion

KANSAS
 Map No. *map* Sec. *15* Twp. *17* R. *4*

Well No. *1* *Town Hat*

Asurwood & Winters Company

Contractor

FIRST REPORTS

SECTION PLAT

330 Ft. from N. Line

_____ Ft. from S. Line

990 Ft. from E. Line

_____ Ft. from W. Line

			<i>o</i>

Location _____

Rig up

Drilling and Remarks:

RECORD

Cased _____ in., _____ ft.

Sand _____

Gas _____

Oil _____

Total Depth _____

PRODUCTION

1st 24 hrs. Nat. _____

1st 24 hrs. after shot _____

Gas _____ Cu. Ft.

Dry Hole _____

Abandoned _____

Date
SEP 23 1927

CHAS. L. SHERWOOD

_____ 192 _____ Scout

*no wall map
no small map*

Returned.....
Gards.....
Tracing <i>None</i>
France Map.....
Scarborough Map
Moody Map.....
Scarborough Plat Book.....
Moody Plat Book.....

MAP No. _____ SEC. 15 TWP. 17S R. 4E

WELL No. 1 Down Smith
Howard & Winters COMPANY

no wall mng

_____ CONTRACTOR

SECTION PLAT

			0

_____ FT. FROM N. LINE
 _____ FT. FROM S. LINE
 _____ FT. FROM E. LINE
 _____ FT. FROM W. LINE

LOCATION _____
 RIG UP _____
 DRILLING AND REMARKS:

RECORD

CASED _____ IN. _____ FT.
 SAND _____
 GAS _____
 OIL _____
 TOTAL DEPTH 24¹⁰⁹ 29

PRODUCTION

1ST 24 HRS. NAT. _____
 1ST 24 HRS. AFTER SHOT _____
 GAS _____ CU. FT.
 DRY HOLE
 ABANDONED

DATE 1/17 1928 _____ SCOUT

Marion
 Map No. **KANSAS** Sec. *15* Twp. *17* R. *4*
 Well No. *1 Town lot*
Harwood & Winters Company

Contractor

COMPLETED

SECTION PLAT

330 Ft. from N. Line
 _____ Ft. from S. Line
990 Ft. from E. Line
 _____ Ft. from W. Line

			<i>0</i>

ABANDONED

Location _____

Rig up _____

Drilling and Remarks:

Tap Chst 2385
Water 2402 - 2414
5" 2417
Chst & Pay 2435-39
1450' down hole.
Abandon on acct Pay

RECORD

Cased _____ in., _____ ft.
 Sand _____
 Gas _____
 Oil _____
 Total Depth *2439*

PRODUCTION

1st 24 hrs. Nat. _____
 1st 24 hrs. after shot _____
 Gas _____ Cu. Ft.
 Dry Hole _____
 Abandoned

Yshy Yeh
 Date
JAN 18 1928

CHAS. L. SHERWOOD
 Scout

CAU

11911

No WAIT MAP

No Small map

Returned	
Cards	_____
Tracing	_____
France Map	
Scarborough Map	X
Edy Map	
Bank	