

Sec. 15 Twp. 17 R. 5E

Well No. #1 Peterson Farm

Loomis & Artnell Company

Contractor

Burdeck Pool


Ft. from N. Line

990' Ft. from S. Line

Ft. from E. Line

990' Ft. from W. Line

NE SW SW

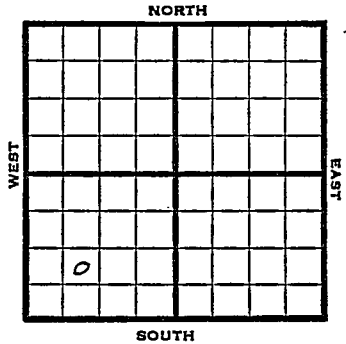

1950 Elev. 1468' REPORT

4/26 Cellar & Pits
 12/13 D&A TD 2280
 13" @ 193 10" @ 1255
 8" @ 1529 KC 1725
 6-5/8" @ 1725' 5" @ 2030
 Chat 2195 Underream 5" @ 2200'
 TD 2280 D&A

ABANDONED

Map No. _____ Sec. 15 Twp. 17 R. 5E

Well No. 1 Peterson

Loomis & Artnell Company

Contractor

NE SW SW

SECTION PLAT

_____ Ft. from N. Line
990 Ft. from S. Line
_____ Ft. from E. Line
990 Ft. from W. Line



Morris County

Location _____

Rig up _____

Drilling and Remarks:

Cellar & pits

RECORD

Cased _____ in., _____ ft.
Sand _____
Gas _____
Oil _____
Total Depth _____

PRODUCTION

1st 24 hrs. Nat. _____
1st 24 hrs. after shot _____
Gas _____ Cu. Ft.
Dry Hole _____
Abandoned _____

Date

APR 26 1950 19

J. E. TYRA Scout


County Morris State Kansas

Sec. 15 (Blk. 1 Twp.) 17 (Sur. 5E Rge.) Map No.

Operator Loomis & Artnell

Well No. 1 Farm. Peterson

Elev. 1468 Location NE SW SW

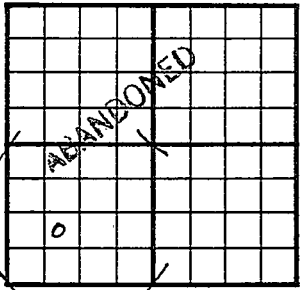

990 Ft. From S Line SW

990 Ft. From W Line Quarter

Ist. Report

Completion DEC 13 1950

Remarks Furdwick Pool

Spudding Date

Drlg. Data D & A TD 2280

13" @ 193 10" @ 1255 8" @ 1529

KC 1725 6 5/8" @ 1725 5" @ 2030

Chat 2195 Underream 5" @ 2200 TD 2280

D & A

J. E. TYRA