


Map No. KANSAS Sec. 15 Twp. 17 R. 7E
Well No. 5 Thilde Farm
Arrow Dr G Company

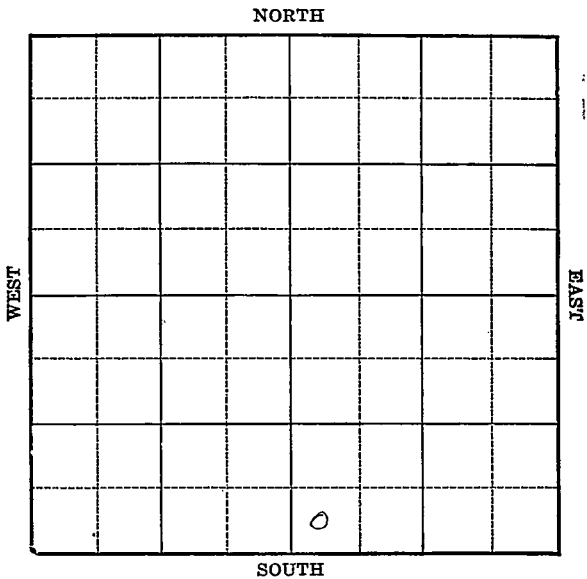

Location _____
Drilling Remarks _____

Rig Up _____
Drilling Remarks _____

RECORD

Cased _____ in. _____ ft.
Sand _____
Gas _____
Oil _____
Total Depth _____

PRODUCTION

1st 24 hrs. Nat. _____
1st 24 hrs. after shot _____
Gas _____ cu. ft. _____
Dry Hole _____
Abandoned _____

5/13 Gas 1238-48
T.D. 1248'
1 1/2 M gas
Comp

Map No. **KANSAS** Sec. **15** Twp. **17** R. **7**
 Well No. **27** **5** **Wicks**

arrow oil & gas Co Company

Contractor

FIRST REPORTS

.....Ft. from N. Line

250 Ft. from S. Line

.....Ft. from E. Line

250 Ft. from W. Line

SECTION PLAT

Location.....

Rig up.....

Drilling and Remarks:

Apby

RECORD

Cased.....in.,ft.

Sand.....

Gas.....

Oil.....

Total Depth.....

PRODUCTION

1st 24 hrs. Nat.....

1st 24 hrs. after shot.....

Gas.....Cu. Ft.

Dry Hole.....

Abandoned.....

Date
DEC 3 0 1930

192 **CHAS. L. SHERWOOD** Scout

Morris

 Map No. KANSAS Sec. 15 Twp. 17 R. 7 ^E
 Well No. 275 Wild
Arrow Oil & Gas Co Company

Contractor

COMPLETED

SECTION PLAT

		0	

Ft. from N. Line

250 Ft. from S. Line

Ft. from E. Line

250 Ft. from W. Line

Location

Rig up

Drilling and Remarks:

RECORD

Cased in., ft.

Sand

 Gas 1238-1248

Oil

 Total Depth 1248

PRODUCTION

1st 24 hrs. Nat.

1st 24 hrs. after shot

 Gas 1 1/2 M Cu. Ft.

Dry Hole

Abandoned

Date

MAY 13 1931

CHAS. L. SHERWOOD

192 Scout

no small map
west

Returned	_____
Cards	_____ <i>AB</i>
Tracing	_____ <i>ASH</i>
France Map	_____ <i>X</i>
Scarborough Map	_____ <i>AB</i>
Moody Map	_____ <i>X</i>
Scarborough Plat Book	_____
Moody Plat Book	_____