

NORTH

WEST

EAST

SOUTH

Drilling Remarks

Total Depth_____

Abandoned_____


Map No. KANSAS Sec. 15 Twp. 17 R. 7E
Well No. 3- Helix Farm
Arrow Oil Company

1120 Ft. from N. Line

 Ft. from S. Line

200 Ft. from E. Line

 Ft. from W. Line

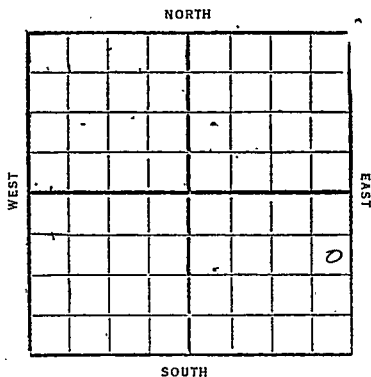

Date

REPORT.

12/30

1
Band 1655-66
TD 1666
2 7/8 gas
500# R.P.
Comp.

Map No. KANSAS Sec. 15 Twp. 17 R. 7
 Well No. 273 Wills

arrow oil & gas co Company

FIRST REPORTS

Contractor

COMPLETE

SECTION PLAT

1120 Ft. from N. Line

..... Ft. from S. Line

800 Ft. from E. Line

..... Ft. from W. Line

			0

Location.....

Rig up.....

Drilling and Remarks:

500 # Rp.

RECORD

Cased..... in., ft.

Sand 1655-1666

Gas.....

Oil.....

Total Depth 1666

PRODUCTION

1st 24 hrs. Nat.....

1st 24 hrs. after shot.....

Gas 2 M Cu. Ft.

Dry Hole.....

Abandoned.....

Date
DEC 30 1930

CHAS. L. SHERWOOD

192.....

Scout

Returned _____
Cards _____
Tracing over _____
France Map X _____
Scarborough Map X _____
Moody Map X _____
Scarborough Plot Book _____
Moody Plot Book _____