

DX 78-1


Marion

KANSAS

Section 16 Township 17 Range 4E

Well No. #1 Hajek

Company Augusta Oil

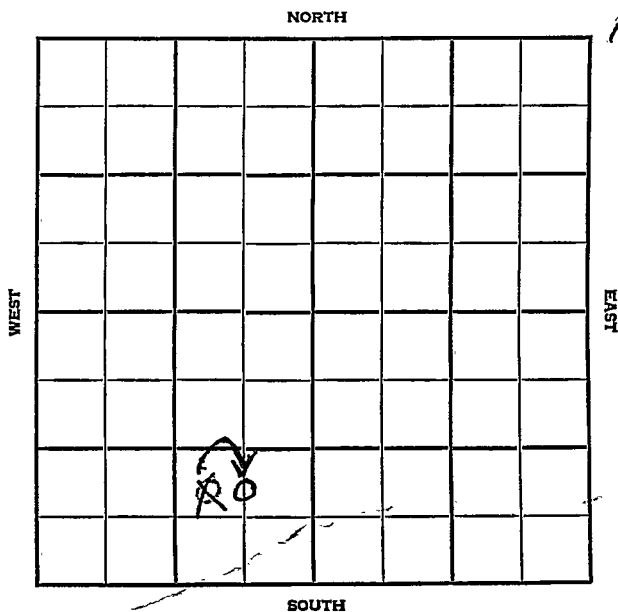

Marion

KANSAS

|      |      |    |
|------|------|----|
| SEC. | TWP. | R. |
| 16   | 17   | 4E |

WELL NO.

1 Hajek

FARM

COMPANY

Augusta Oil

CONTRACTOR

Co. Tools

Lost Springs Pool

Ft. from N. Line

990'


Ft. from S. Line

660

990'

Ft. from E. Line

Ft. from W. Line

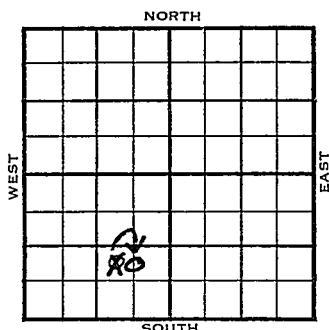~~NW SE SW~~

CN/2 SE SW

1955

ELEVATION

REPORT

5/25

M I R

6/29

Comm 5-24-55

8 5/8", @128/100, 5 1/2" @ 2330/35

DD 2348 FU 550' oil 100' sw 16 hr.

Frac Comp. 50 bopd 15 bw.

Tops: Depth

Datum

M.ch. 2330

890

TD. 2337

COMPLETED

County Marion State KansasSec. 16 (Blk. Twp.) 17 (Sur. Rge.) 4E Map No. \_\_\_\_\_Operator Augusta OilWell No. 1 Farm HajekElev. \_\_\_\_\_ Location NW SE SW

|  |  |  |  |  |  |  |  |
|--|--|--|--|--|--|--|--|
|  |  |  |  |  |  |  |  |
|  |  |  |  |  |  |  |  |
990 Ft. From S Line SW990 Ft. From E Line Quarter1st. Report MAY 25 1955

Completion \_\_\_\_\_

Remarks \_\_\_\_\_

Co. tools

Spudding Date \_\_\_\_\_

Drlg. Data Lost Springs PoolM I R

MAY 27 1955

|                |            |
|----------------|------------|
| Scout Cards    | <i>mmc</i> |
| Land Small Map |            |
| Land Wall Map  |            |
| Tracings       |            |
| France Map     |            |
| Pierce Map     |            |
| Misc           |            |

Orig. Data

## SCOUT TICKET

DX-201

Kansas

SEC.

16

TWP.

17

R.

4E

WELL NO.

1 Hajek

FARM

COMPANY

Augusta Oil

CONTRACTOR

CORRECTION


C N  $\frac{1}{2}$  SE SW

\_\_\_\_ FT. FROM N. LINE

990 FT. FROM S. LINE

660 FT. FORM E. LINE

\_\_\_\_ FT. FROM W. LINE

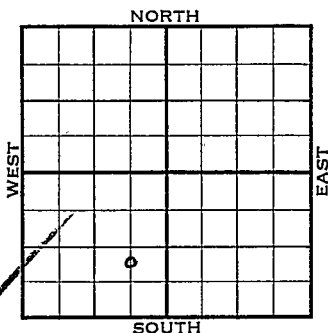

Marion County

☐

LOCATION

☐

RIG UP

DRILLING AND REMARKS:

Reported

NW SE SW

RECORD

CASED IN., FT.

SAND

GAS

OIL

TOTAL DEPTH

1ST 24 HRS. NAT.

1ST 24 HRS. AFTER SHOT

GAS CU. FT.

DRY HOLE

ABANDONED

PRODUCTION

DATE

JUN 15 1955

SCOUT

L. J. Harris

WOLTON & CO


|                |    |
|----------------|----|
| Scout Cards    | mm |
| Land Small Map |    |
| Land Wall Map  |    |
| Tracings       |    |
| France Map     |    |
| Pierce Map     |    |
| Misc.          |    |

JUN 16 1955

County Marion Elev. 1440  
Sec. 16 Twp. 17 Rge. 4E  
Company Augusta Oil  
Farm Name Hajek No. 1

| TOPS         | DEPTH       | LOG | DATUM      |
|--------------|-------------|-----|------------|
| Anh.         |             |     |            |
| Tr.          |             |     |            |
| H.           |             |     |            |
| Tr.          |             |     |            |
| Dg.          |             |     |            |
| BL.          |             |     |            |
| L.           |             |     |            |
| K.C.         |             |     |            |
| B.K.C.       |             |     |            |
| Ce.          |             |     |            |
| C.           |             |     |            |
| M. <u>ch</u> | <u>2330</u> |     | <u>890</u> |
| M.           |             |     |            |
| K.           |             |     |            |
| Mz.          |             |     |            |
| Ma.          |             |     |            |
| V.           |             |     |            |
| S.           |             |     |            |
| S.           |             |     |            |
| A.           |             |     |            |
| R.           |             |     |            |
| PE.          |             |     |            |
| G.           |             |     |            |
| T.D.         | <u>2337</u> |     |            |

Loc. in Sec. C N<sup>1</sup>/<sub>2</sub> SE SW  
Geol. \_\_\_\_\_  
Contr. \_\_\_\_\_  
Co. tools \_\_\_\_\_  
Pool \_\_\_\_\_  
Lost Springs \_\_\_\_\_

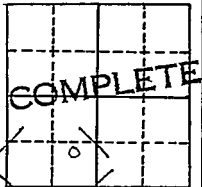

Date Comm. 5-24-55 JUN 2-9 1955  
8 5/8" @ 128/100 5 1/2" @ 2330/35  
DD 2348 FU 550' oil 100' sw 16 hr.  
frac Comp. 50 bopd 15 bw

Scout Cards ..... JC  
Large Small Map .....  
Land Wall Map .....  
Tracings .....  
France Map .....  
Pierce Map .....  
Misc. ... ..

JUL 8 1955