


Marion KANSAS
Marion KANSAS

DX 78-1

Section 2 Township 17 Range 1E

Well No. 1 Martin

Company Daetwiler et al

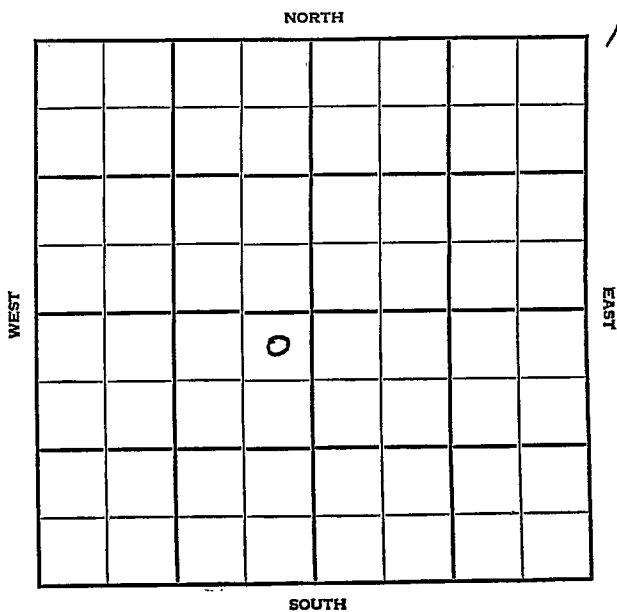

Marion KANSAS




SEC.	TWP.	R.
M 2	17	1E

WELL NO. 1 Martin FARM

COMPANY Daetwiler et al

CONTRACTOR Slusser Drlg
Lost S; rings Pool

330 Ft. from N. Line
Ft. from S. Line
330 Ft. from E. Line
Ft. from W. Line

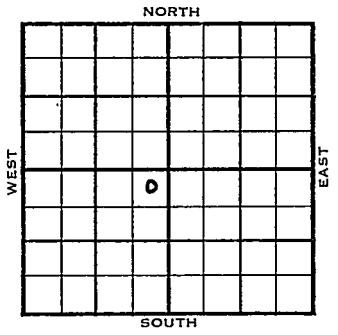

NE NE SW

1954	ELEVATION 1452	REPORT
------	----------------	--------

6/30 R U R
7/28 Spdg 7-1-54
Oil well
TD 2359
8" @ 95
Miss 2320
TD 2359
5" @ 2359
GO to 2356 60/2331-48 500 A frac
Comp. 4 bopd

COMPLETED

