


Map No. _____ Sec. 2 Twp. 17 R. 4

Well No. 1-Smott Farm _____
Harwood & Winters Company

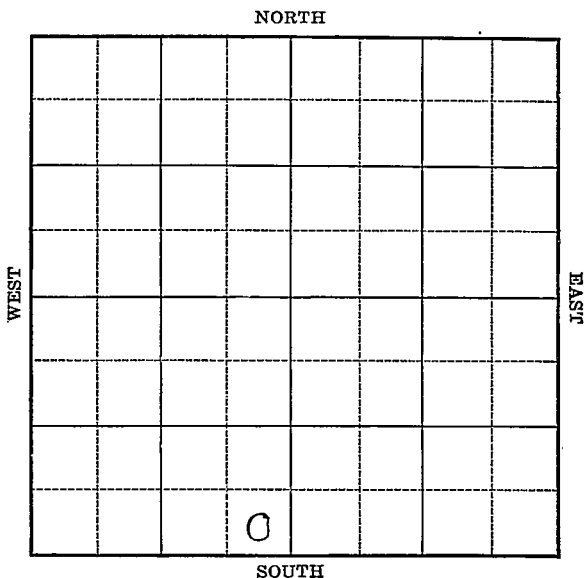

Location _____

Drilling Remarks _____

RECORD

Cased _____ in. _____ ft.

Sand _____

Gas _____

Oil _____

Total Depth _____

Rig Up _____

Drilling Remarks _____

PRODUCTION

1st 24 hrs. Nat. _____

1st 24 hrs. after shot _____

Gas _____ cu. ft.

Dry Hole _____

Abandoned _____

~~NO KANSAS~~

Macion

E

Map No. _____ Sec. 2 Twp. 17 R. 4

Well No. 1 Mott

Hawwood & Winters Company

Contractor

FIRST REPORTS

_____ Ft. from N. Line

330 Ft. from S. Line

330 Ft. from E. Line

_____ Ft. from W. Line

SECTION PLAT

	o		

Location

Rig up _____

Drilling and Remarks:

RECORD

Cased _____ in., _____ ft.

Sand _____

Gas _____

Oil _____

Total Depth _____

PRODUCTION

1st 24 hrs. Nat. _____

1st 24 hrs. after shot _____

Gas _____ Cu. Ft.

Dry Hole _____

Abandoned _____

Date OCT 19 1927

CHAS. L. SHERWOOD

Marion

Map No. *no drawing* **KANSAS** - Sec. *7* Twp. *17* R. *4*

Well No. *1* *Matt*

Harwood & Winters Company

Contractor

COMPLETED

SECTION PLAT

----- Ft. from N. Line

330 Ft. from S. Line

330 Ft. from E. Line

----- Ft. from W. Line

ABANDONED

Location -----

Rig up -----

Drilling and Remarks:

Chat 2794-2384
Rainbow show

224
2390

RECORD

Cased ----- in., ----- ft.

Sand -----

Gas -----

Oil -----

Total Depth *2390*

PRODUCTION

1st 24 hrs. Nat. -----

1st 24 hrs. after shot -----

Gas ----- Cu. Ft.

Dry Hole

Abandoned

Date

DEC 21 1927

CHAS. L. SHERWOOD
Scout

MAP No. _____ SEC. 2 TWP. 17S R. 4E

WELL No. 1 Mat

Howard COMPANY

no wall map CONTRACTOR

SECTION PLAT

_____ Ft. FROM N. LINE
 _____ Ft. FROM S. LINE
 _____ Ft. FROM E. LINE
 _____ Ft. FROM W. LINE

LOCATION _____

RIG UP _____

DRILLING AND REMARKS:

RECORD

CASED _____ IN. _____ FT.
 SAND _____
 GAS _____
 OIL _____
 TOTAL DEPTH 7390

PRODUCTION

1ST 24 HRS. NAT. _____
 1ST 24 HRS. AFTER SHOT _____
 GAS _____ CU. FT.
 DRY HOLE
 ABANDONED _____

DATE 12/20 1927

SCOUT