


Map No. _____ Sec. 2 Twp. 17 R. 4E

Well No. 1 - Ucker Farm _____
Harwood & Winters Company

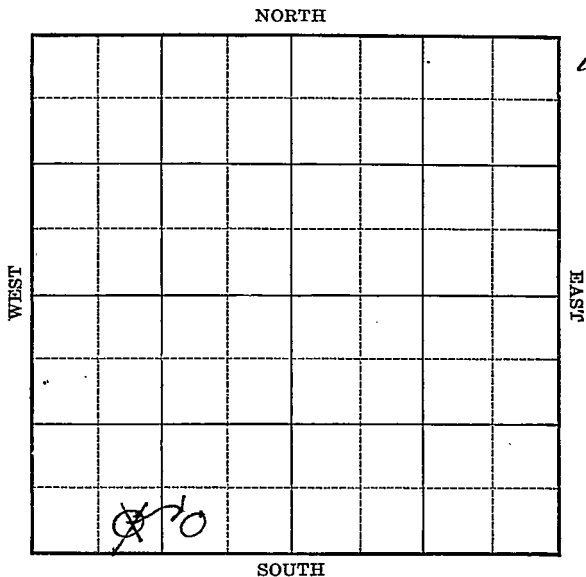

Location _____

Drilling Remarks _____

Rig Up _____

Drilling Remarks _____

RECORD

Cased _____ in. _____ ft.

Sand _____

Gas _____

Oil _____

Total Depth _____

PRODUCTION

1st 24 hrs. Nat. _____

1st 24 hrs. after shot _____

Gas _____ cu. ft.


Dry Hole _____

Abandoned _____

Map No. _____ Sec. 2 Twp. 17 R. 4 E

Well No. 1-Ucker Farm
Harwood & Winters Company

NORTH

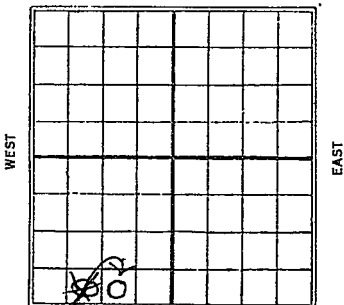

_____ Ft. from N. Line

330 Ft. from S. Line

990 Ft. from E. Line

~~990~~ Ft. from W. Line

SOUTH

1927

Date

REPORT

7/20	Location
7/28	Timbers
8/4	rigging up
8/10	Rig up
8/18	log tools 1160
8/24	Drlg 1475-
9/1	" 1750
9/7	Runig 6' - 2246-
9/14	Drlg 2330
9/29	Chat 2364-2449- 500' oil + 600' water in hole - u.R. 6'
10/6	Chat 2364-2449 - Swabbed 12 bbls oil + 5 bbls water in 7 1/2 hrs
10/12	fishing Casing
10/19	—
10/27	Chat 2364-2449 Swabbed 12 bbl oil + 5 bbl water in 7 1/2 hrs. f.s.g. casing
11/2	—
11/9	—
	11/16 —

11/23 - feq. caq.

11/30 - _____

12/7 _____

12/14 _____

12/21 _____

12/29 _____

~~1928~~
1/5 _____

1/11 - 2364-2449 (chat)
T.D. 2449 25 bbb

Map No. KANSAS Sec. 2 Twp. 17 R. 4

Well No. 1 McKen

Harwood & Winters Company

Contractor

Nation E

FIRST REPORTS

_____ Ft. from N. Line

330 Ft. from S. Line

_____ Ft. from E. Line

990 Ft. from W. Line

SECTION PLAT

o			

Location

Rig up _____

Drilling and Remarks:

RECORD

Cased _____ in., _____ ft.

Sand _____

Gas _____

Oil _____

Total Depth _____

PRODUCTION

1st 24 hrs. Nat. _____

1st 24 hrs. after shot _____

Gas _____ Cu. Ft.

Dry Hole _____

Abandoned _____

Date JUL 20 1927

CHAS. L. SHERWOOD

192 Scout

Page: 1
Continued

SCARBOROUGH PLAT





No
 MAIL
 MAP

Returned	
Cards	<i>None</i>
Tracing	<i>None</i>
France Map	
Scarborough Map	<i>X</i>
Moody Map	
Scarborough Plat Book	
Moody Plat Book	

KANSAS

Mallion

E

Map No. *no map* Sec. *2* Twp. *17* R. *4*

Well No. *1* *Meters*

Harwood & Winters Company

Contractor

CORRECTION

SECTION PLAT

_____ Ft. from N. Line

330

_____ Ft. from S. Line

990

_____ Ft. from E. Line

_____ Ft. from W. Line

	<i>60</i>	<i>0</i>	

Location _____

Keen up

Rig up _____

Drilling and Remarks:

Chg location to above

RECORD

Cased _____ in., _____ ft.

Sand _____

Gas _____

Oil _____

Total Depth _____

PRODUCTION

1st 24 hrs. Nat. _____

1st 24 hrs. after shot _____

Gas _____ Cu. Ft.

Dry Hole _____

Abandoned _____

Date

AUG 10 1927

CHAS. L. SHERWOOD

192

Scout

No wall
map

PLATE 100 A
<i>[Signature]</i>
Tracing <i>[Signature]</i>
France Map
Scarborough Map <i>X</i>
Moody Map
Scarborough Plat Book
Moody Plat Book

Malton

KANSAS
Map No. *730* Sec. *2* Twp. *17* R. *4*

Well No. *1 Meyer*
Harwood & Winters Company

Contractor

COMPLETED

SECTION PLAT

_____ Ft. from N. Line
330 Ft. from S. Line
990 Ft. from E. Line
_____ Ft. from W. Line

	<i>0</i>		

Location _____
Rig up _____
Drilling and Remarks:

25 Bl.

RECORD

Cased _____ in., _____ ft.
~~CHIT~~ Sand *2364-2449*
Gas _____
Oil _____
Total Depth *2449*

PRODUCTION

1st 24 hrs. Nat. _____
1st 24 hrs. after shot _____
Gas _____ Cu. Ft.
Dry Hole _____
Abandoned _____

Date

JAN 11 1928

CHAS. L. SHERWOOD

Scout

